


T. 6 S., R. 4 W., W.M.

RECEIVED

APR 15 1996

WATER RESOURCES DEPT.
SALEM, OREGON

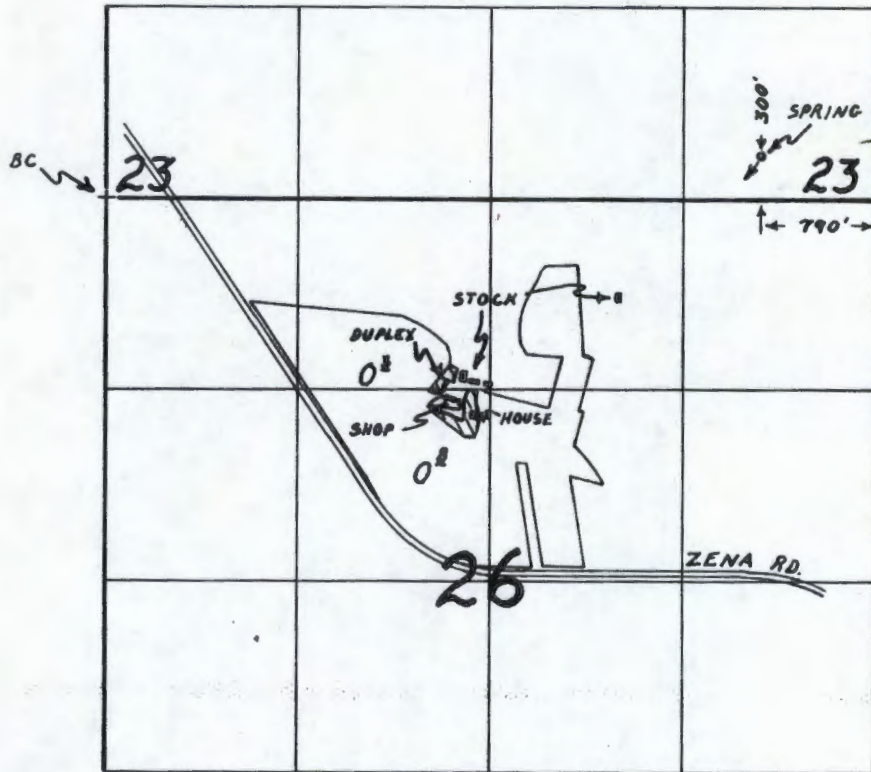

Application No. R-81071
Permit No. 53446

FINAL PROOF SURVEY
UNDER

Application No. 63520 Permit No. 47077
IN NAME OF

Raymond Manning O'Connor

Surveyed July 1, 1993, by R.W. Klassen

This map is only to show the POD. See attached map for POU in Section 23.

23

Application No. 5-8071
Permit No. 58416

400 9850 ACRES


65,000 ACRES

ROCKS

RECEIVED

DEC 11 1996

WATER RESOURCES DEPT.
TALM OREGON

-  PROPERTY BOUNDARY
-  B.O.R. 139/907
-  DOMESTIC USE
-  TANK - FIRE PROTECTION
-  IRRIGATION AND AG (PRIMARYLY PEST SPRAYING)
HATCHING IDENTIFIES 1/4 of 1/4.



SCALE: 1" = 300'

