

T6786

New POD 8-12-97

T.9 S., R. 1 E., W. M.


RECEIVED

JAN 26 1994

WATER RESOURCES DEPT.
SALEM, OREGON



4" = 1 MI.

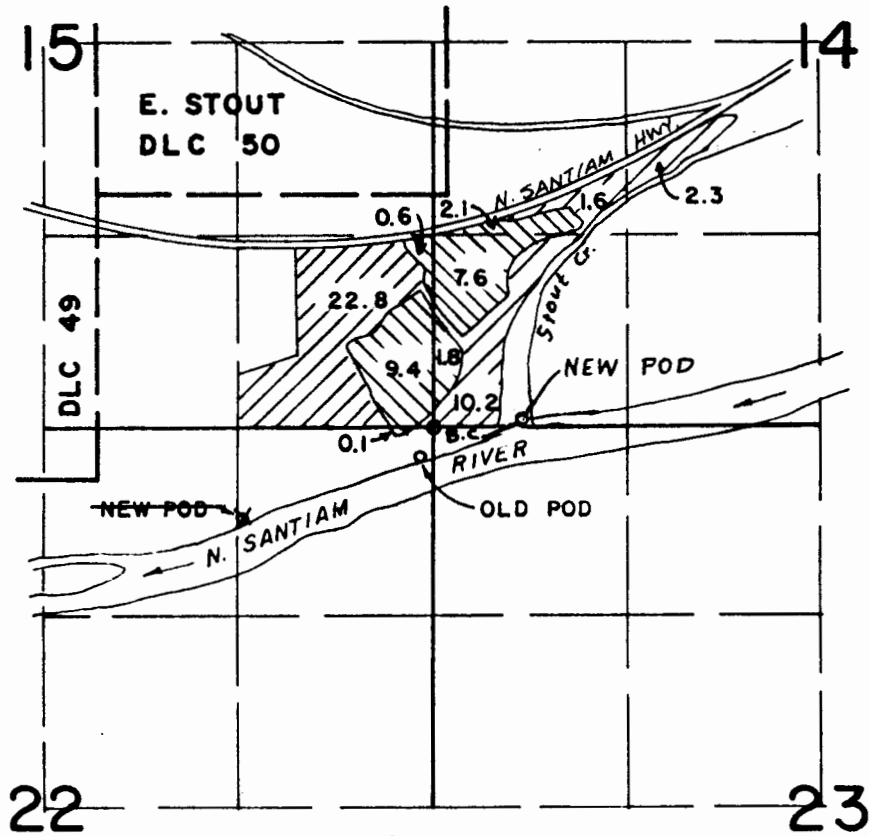

OLD P.O.D. LOC. 210' S. & 70' W. FROM B.C. S.E. COR. SEC. 15

NEW P.O.D. LOC. 250' S. & 270' E. FROM S.W. COR. ~~STOUT DLC 49~~
60' N. 600' Sec. 14

1/24/94
RWJ


PERMIT NO. 39478

THIS APPLICATION

Superseding
WATER RIGHT MAP FOR
A-72569 & T-6786

RICHARD P. & DIANE KOENIG

SURVEYED ON

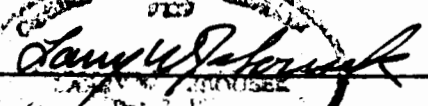BY: 
LARRY J. JOHNSON
DEPT. OF WATER RESOURCES

THIS MAP WAS PREPARED FOR THE PURPOSE OF IDENTIFYING THE LOCATION OF A WATER RIGHT ONLY AND IS NOT INTENDED TO PROVIDE LEGAL DIMENSIONS OR LOCATION OF PROPERTY OWNERSHIP LINES.