



T.39S.,R.3W.,W.M.

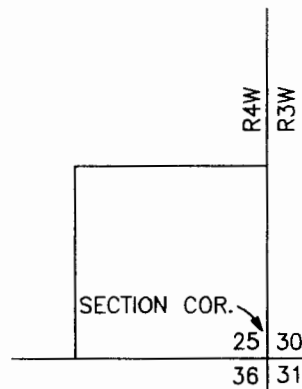


SCALE 1" = 400'

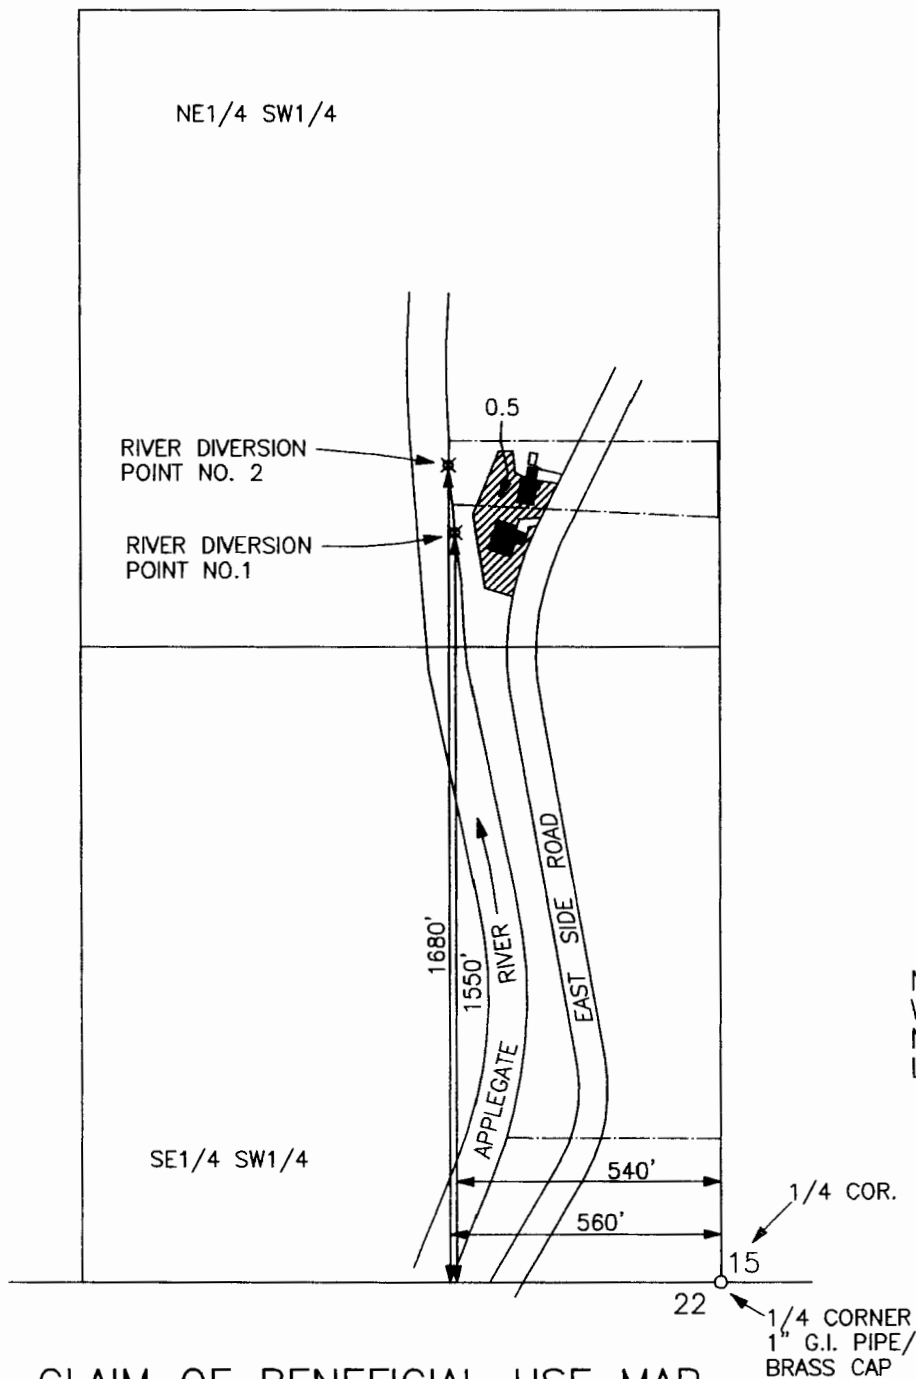

APPLEGATE RESERVIOR  
POINT OF DIVERSION  
SE1/4 SECTION 25  
T.40S.,R.4W.,W.M.  
SCALE 2" = 1 MILE

NOTE: MAP PREPARED FOR  
WATER RIGHT PURPOSES ONLY,  
NOT FOR PROPERTY BOUNDARY  
LOCATIONS.

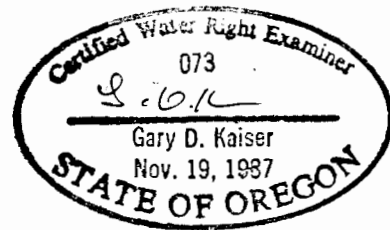


Exp. 6-30-07

### CLAIM OF BENEFICIAL USE MAP

APPLICATION No. S-84043  
PERMIT No. 53652

IN THE NAME OF:  
**ALAN HERSON**  
216 EAST SIDE ROAD  
JACKSONVILLE, OR. 97530

MAP PREPARED SEPTEMBER 15, 2005  
BY GARY D. KAISER

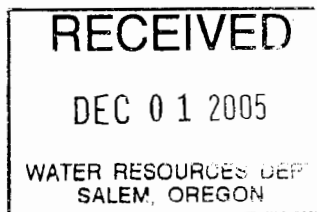

**RECEIVED**


WATER RESOURCES DEPT  
SALEM, OREGON