

Application No. 84193  
Permit No. 53653

T. 24 S., R. 5 W., W.M.

RECEIVED


MAR 15 1999

WATER RESOURCES DEPT.  
SALEM, OREGON

RECEIVED

JUN 29 1999

WATER RESOURCES DEPT.  
SALEM, OREGON

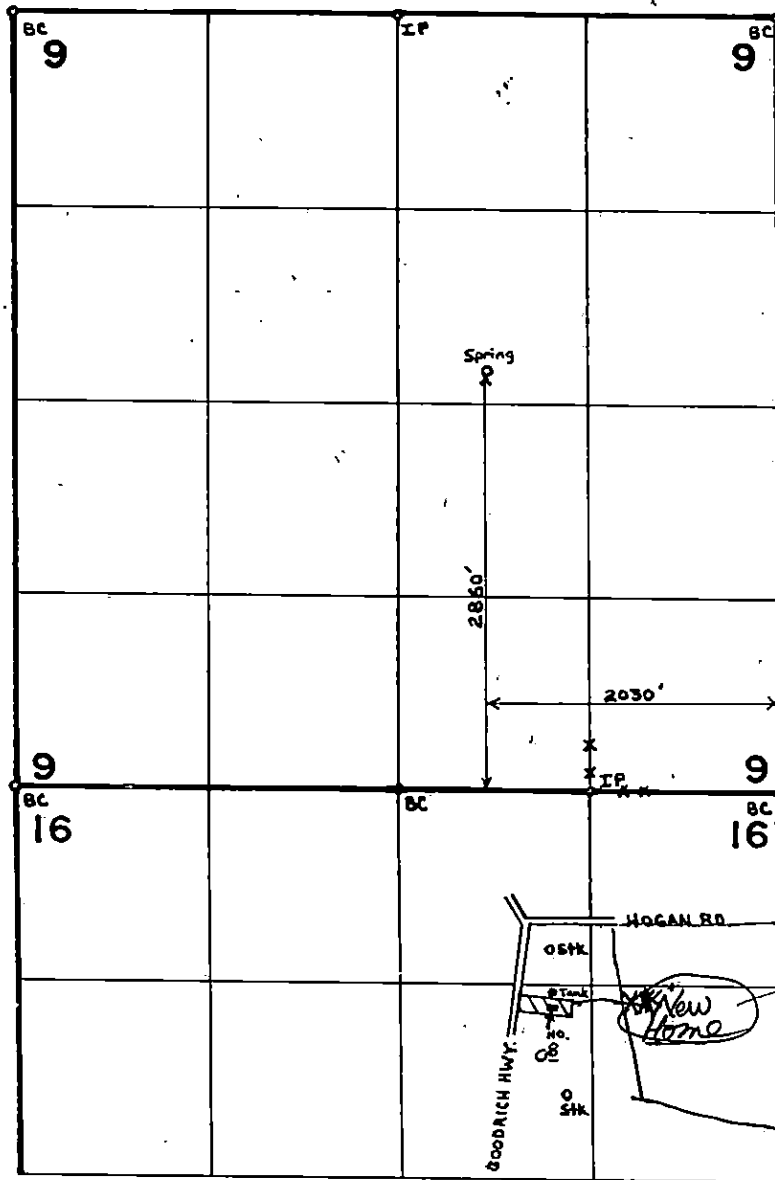

Tax Acct No.  
4583.04  
Tax Lot No. - 800

**FINAL PROOF SURVEY**  
UNDER

Application No. 51259 Permit No. 38714  
IN NAME OF

**LEAMON L. & MIZUE A. JETHRO**

Surveyed MARCH 15 1978, by D.W. SPARKS