


T.6S. R.4 & 5W., W.M.

POLK COUNTY

Application No. 5-84166

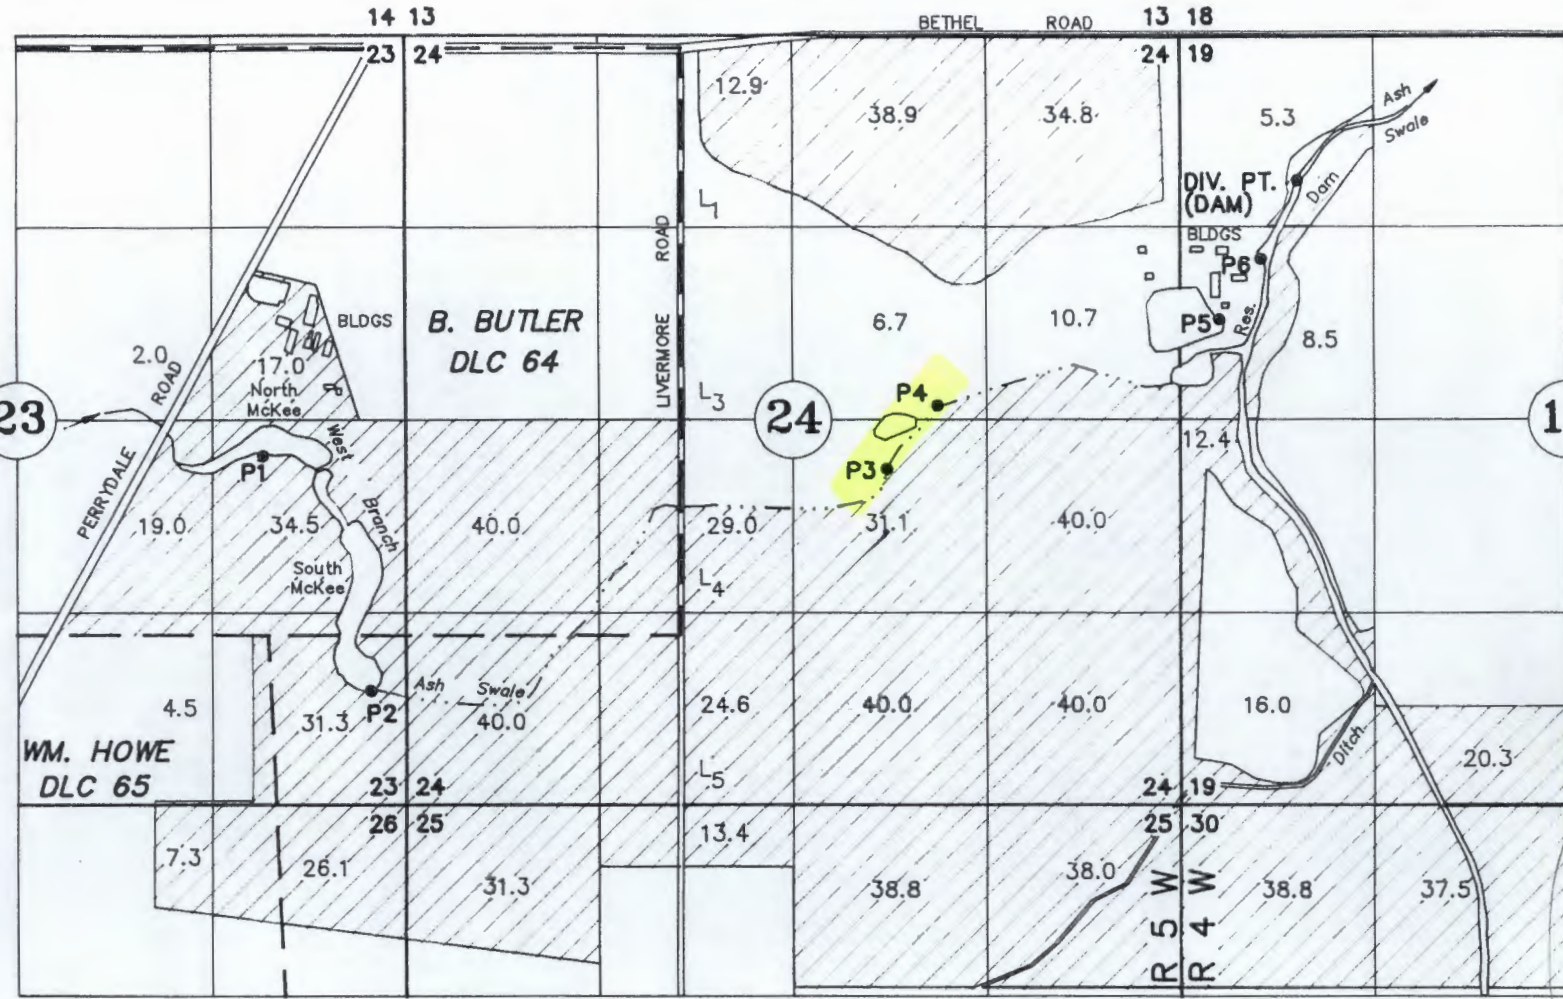

- TAX LOTS:
- 6 5W 23 01000
 - 6 5W 24 00100
00500
 - 6 5W 25 00100
00200
 - 6 5W 26 00100
 - 6 4W 19 00200
 - 6 4W 30 00200

- DIVERSION POINTS:
- DAM: 1000'S & 800'E FROM NW COR. SEC 19
 - P1: 1230' N & 35' W FROM NW COR. OF W. HOWE DLC 65
 - P2: 440' S & 755' E FROM NW COR. OF W. HOWE DLC 65
 - P3: 1140' N & 1405' E FROM SE COR. OF B. BUTLER DLC 64
 - P4: 1570' N & 1755' E FROM SE COR. OF B. BUTLER DLC 64
 - P5: 1955' S & 275' E FROM NW COR. SEC 19
 - P6: 1540' S & 560' E FROM NW COR. SEC 19

RECEIVED

APPLICATION TO APPROPRIATE SURFACE WATER

JUN 08 1999

WATER RESOURCES DEPT.
SALEM, OREGON

APPLICATION No. 84166

R-31602
R-63575
R-

R-2038
R-8399


PERMIT NO. 53656

SCHARF BROS. FARMS

JUNE 07, 1999

SCALE 1" = 1320'

NOT RESERVOIR
ADD'L PUMPING
POINTS FOR
STORAGE
H₂O

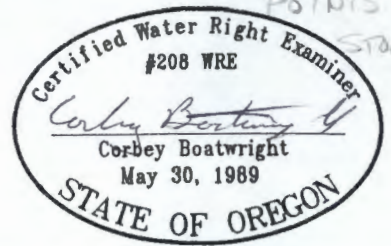

NOTE: This map is for the purpose of identifying the location of water rights and has no intent to dimension or locate property ownership lines.