

Application No. 84135

Permit No. 5367



L.J. FRIAR AND ASSOCIATES

CONSULTING LAND SURVEYORS

816 WEST 8TH STREET
MEDFORD, OREGON 97501

LARRY J. FRIAR
JAMES E. HIBBS






RECEIVED

MAY 06 1999

WATER RESOURCES DEPT.
SALEM, OREGON


PHONE/FAX
541-772-2782

T.36 S., R.3 W., W.M.

-  PRIMARY UNDER CERT. 34034 & 34035 & SUPPL. UNDER CERT. 56562.
-  PRIMARY UNDER CERT. 56562.
-  PRIMARY IRRIG. UNDER CERT. 5556 & TEMPERATURE CONTROL UNDER CERT. 56561. AREA UNDER CERT. 56561 IN ().
-  PROPOSED IRRIG. UNDER THIS APPLICATION.
-  PROPOSED IRRIG. & TEMPERATURE CONTROL UNDER THIS APPLICATION.



SCALE: 1" = 1320'

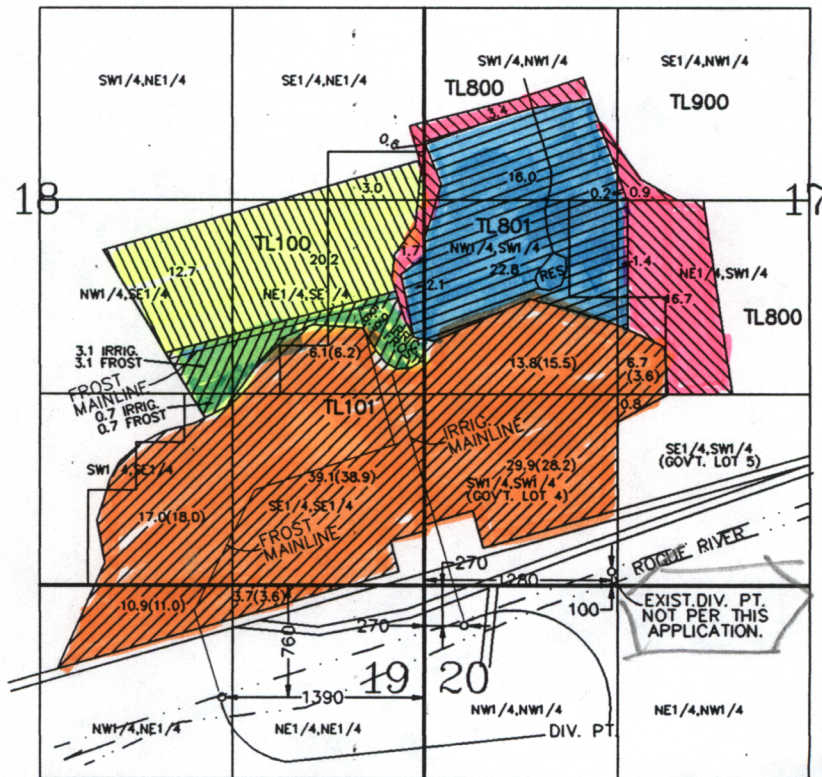

MAP TO ACCOMPANY APPLICATION TO USE SURFACE WATER


FOR:

DEL RIO VINEYARDS, LLC
52 RIVER ROAD
GOLD HILL, OR 97525
PH: (541) 840-6769

BY:

L.J. FRIAR & ASSOCIATES P.C.
CONSULTING LAND SURVEYORS
816 WEST EIGHTH STREET
MEDFORD, OR 97501
PH: 772-2782

THE PREPARATION OF THIS MAP WAS FOR THE PURPOSE OF IDENTIFYING THE WATER RIGHT ONLY & HAS NO INTENT TO PROVIDE DIMENSION OR LOCATION OF PROPERTY OWNERSHIP LINES.

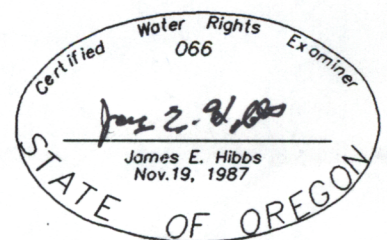

RENEWAL DATE 6-30-99