


Township 35,

Range 38E.

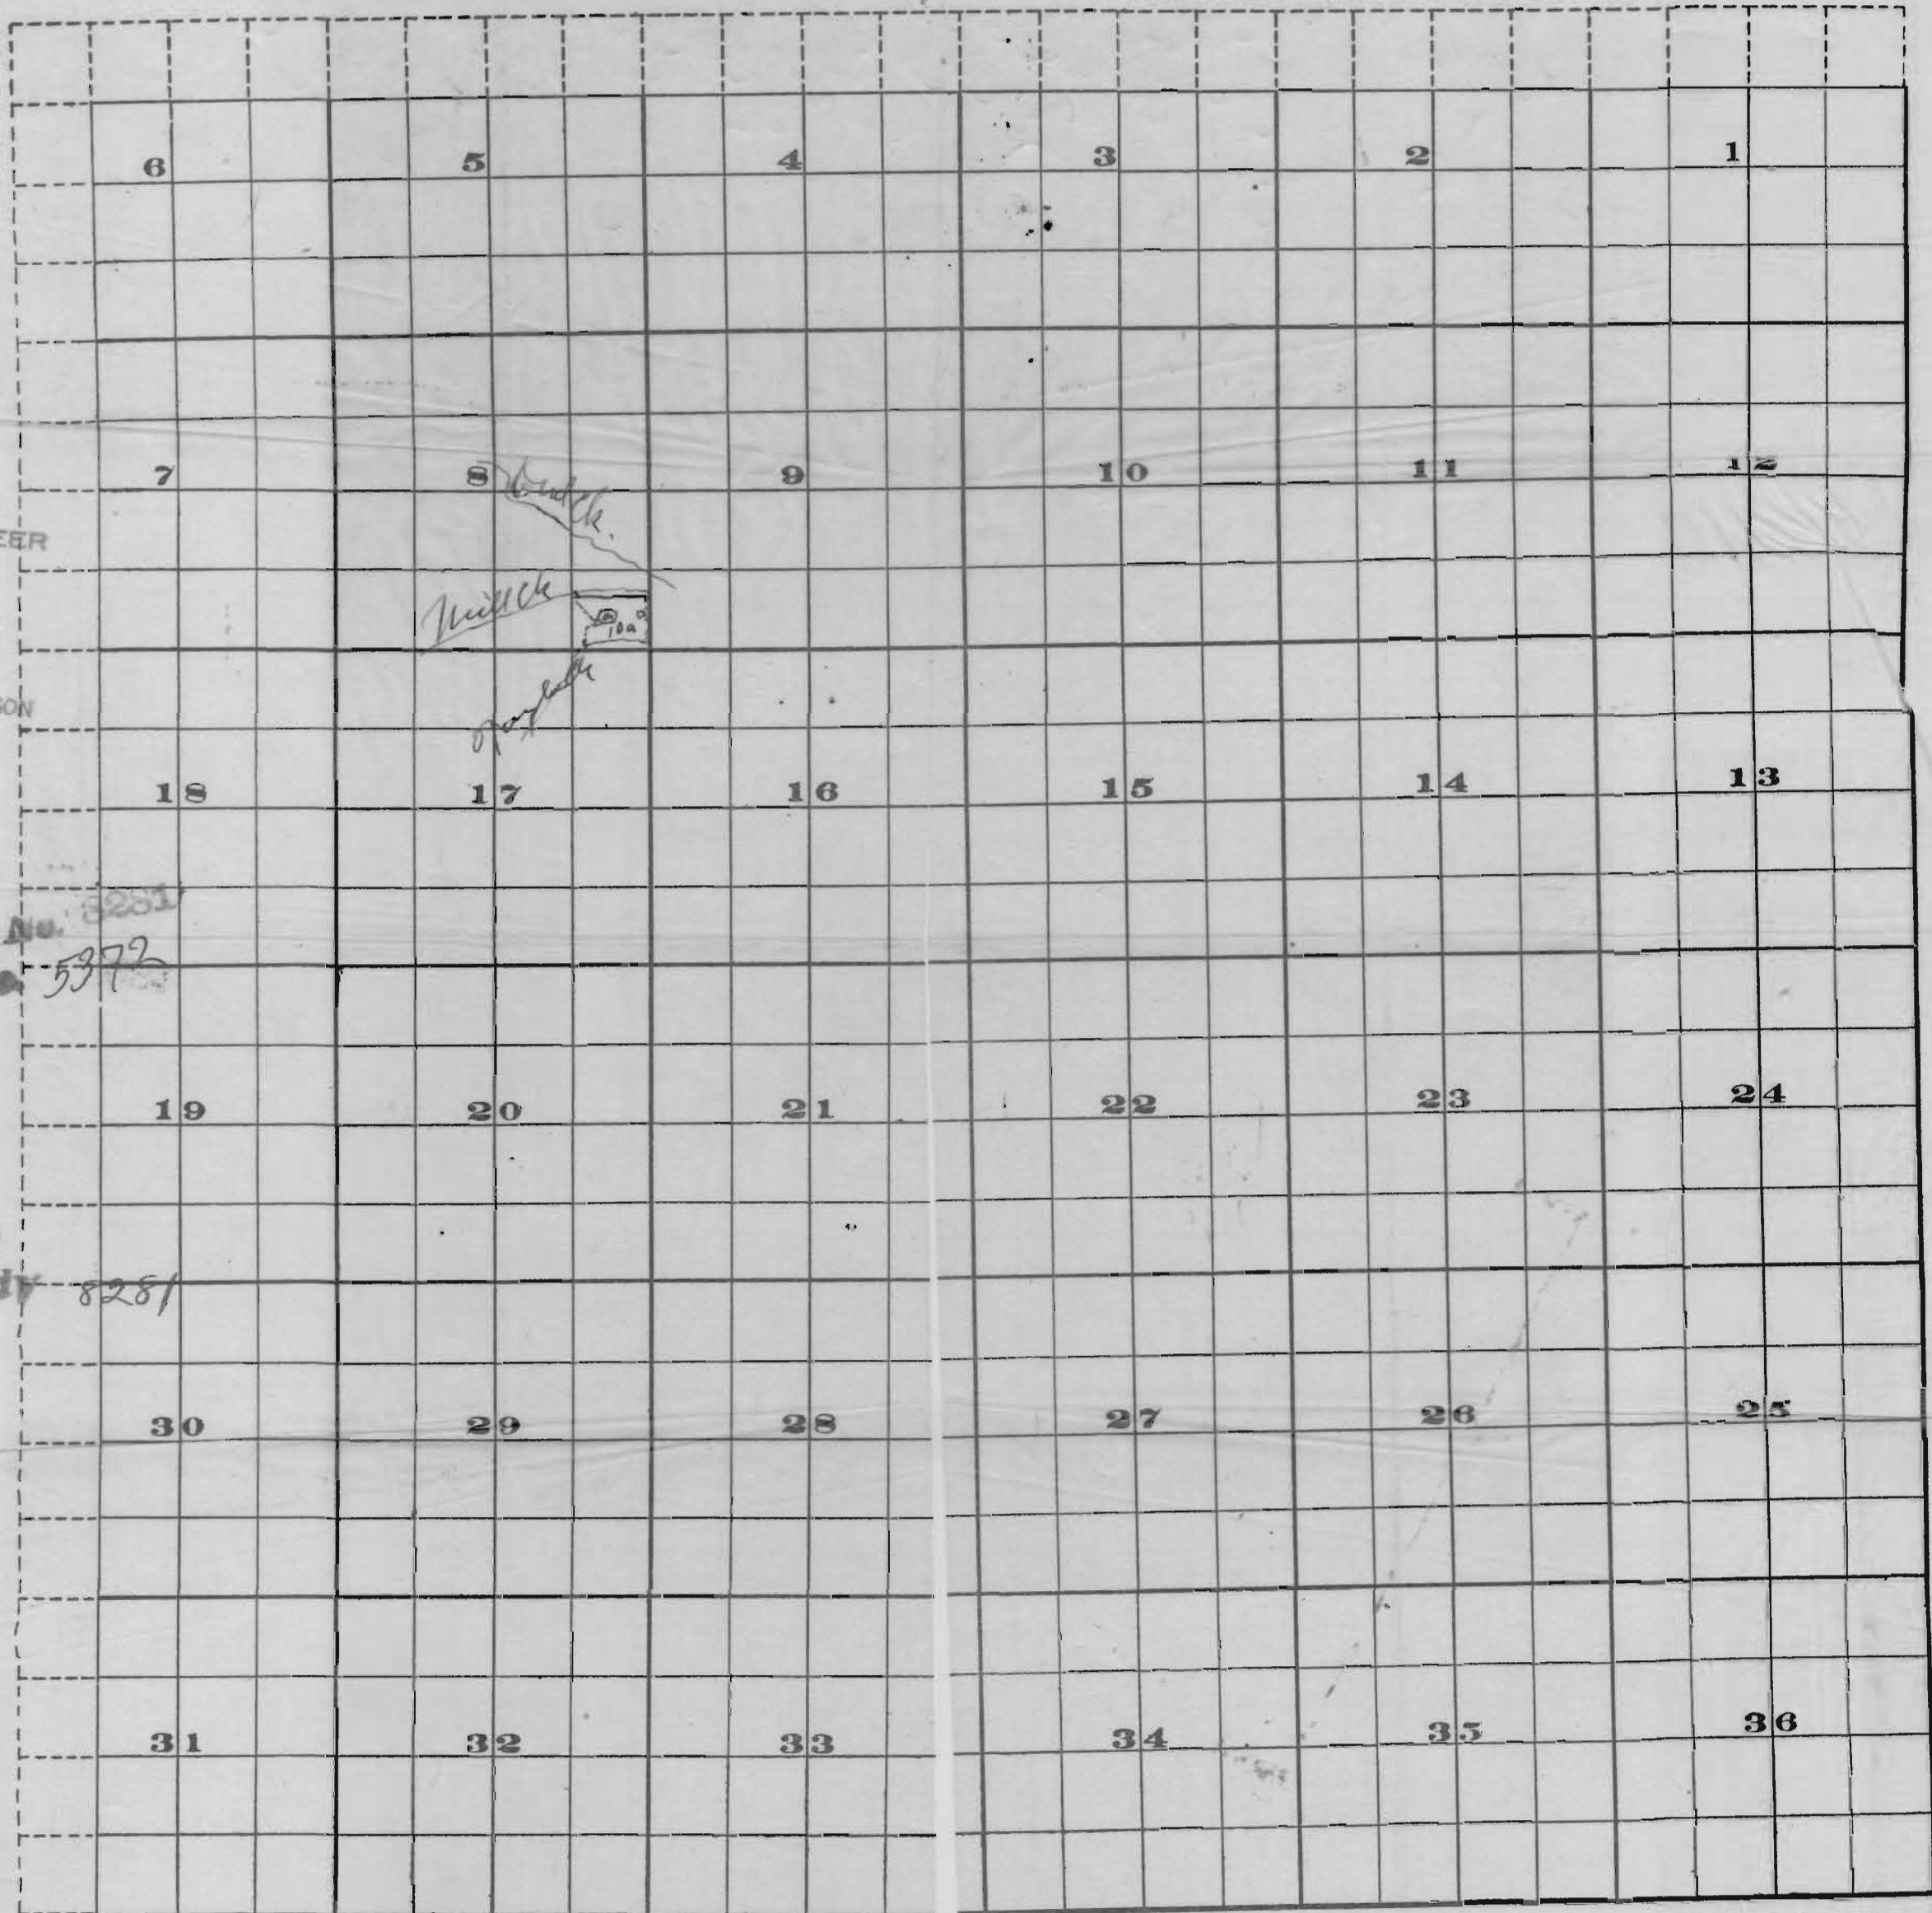

STATE ENGINEER
RECEIVED
MAR 10 1922
SALEM, OREGON

Application No. 3281
Permit No. 5372

Application No. 1828
Permit No.

1828

1828