


TOWNSHIP 33 S RANGE 7 W WM  
JOSEPHINE, COUNTY

App. No. 84218  
Per. No. 53724

33 7

SCALE 1"=400'

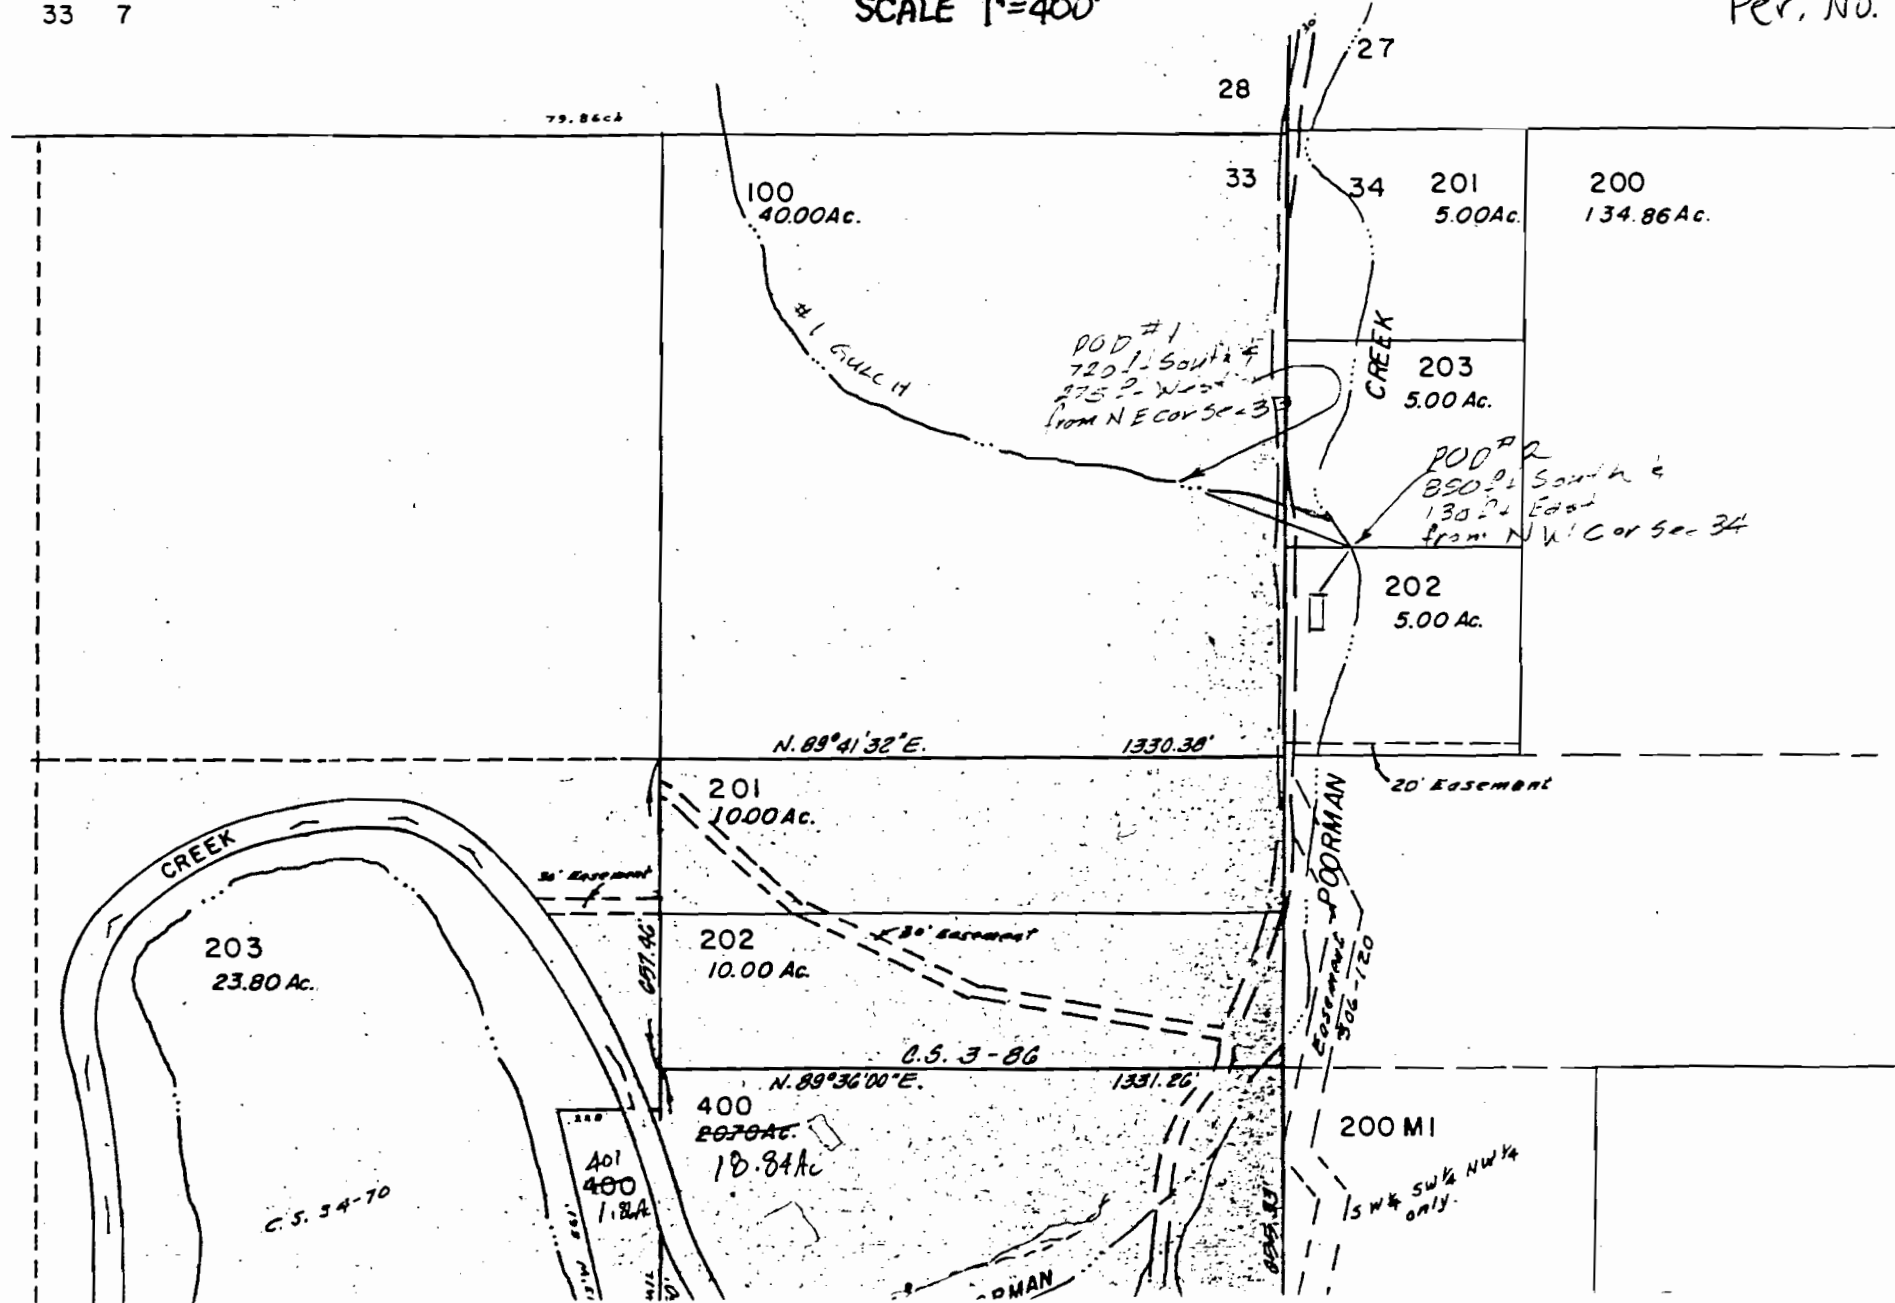

**RECEIVED**

FEB 28 2000

WATER RESOURCES DEPT.  
SALEM, OREGON