

FILE # 5-84624

JACKSON COUNTY

SHADY COVE

T34S R1W

34 1W 21A

IMPORTANT
THIS MAP FOR ASSESSMENT
AND TAXATION PURPOSES
ONLY

SCALE 1/4 INCH = 200 FEET

NE COR
SEC 21

SEE MAP 34 1W 16DC

SEE MAP 34 1W 16DD

APPROX
1/4 CORNER

CNTR
OF
SEC

CANCELLED TAX
LOT NUMBERS


6700	ADWD 10	6695
6702		2402
6801		3410/10-1301
6802		3410/10-1301
6803		2322
6804		4129
6805		1600
6806		1200
6807		3200

RECEIVED

JAN 08 2001

WATER RESOURCES DEPT.
SALEM, OREGON

SCALE 1:4800

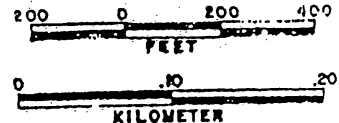


SEE MAP 34 1W 22

SEC 21
T 34S R1W

Jack Stone
1089 Shannon Drive
Medford, OR 97504

COMPILED FROM
INFO IN THE
FILE ON 9/12/01
RUK

34 1W 21A
SHADY COVE

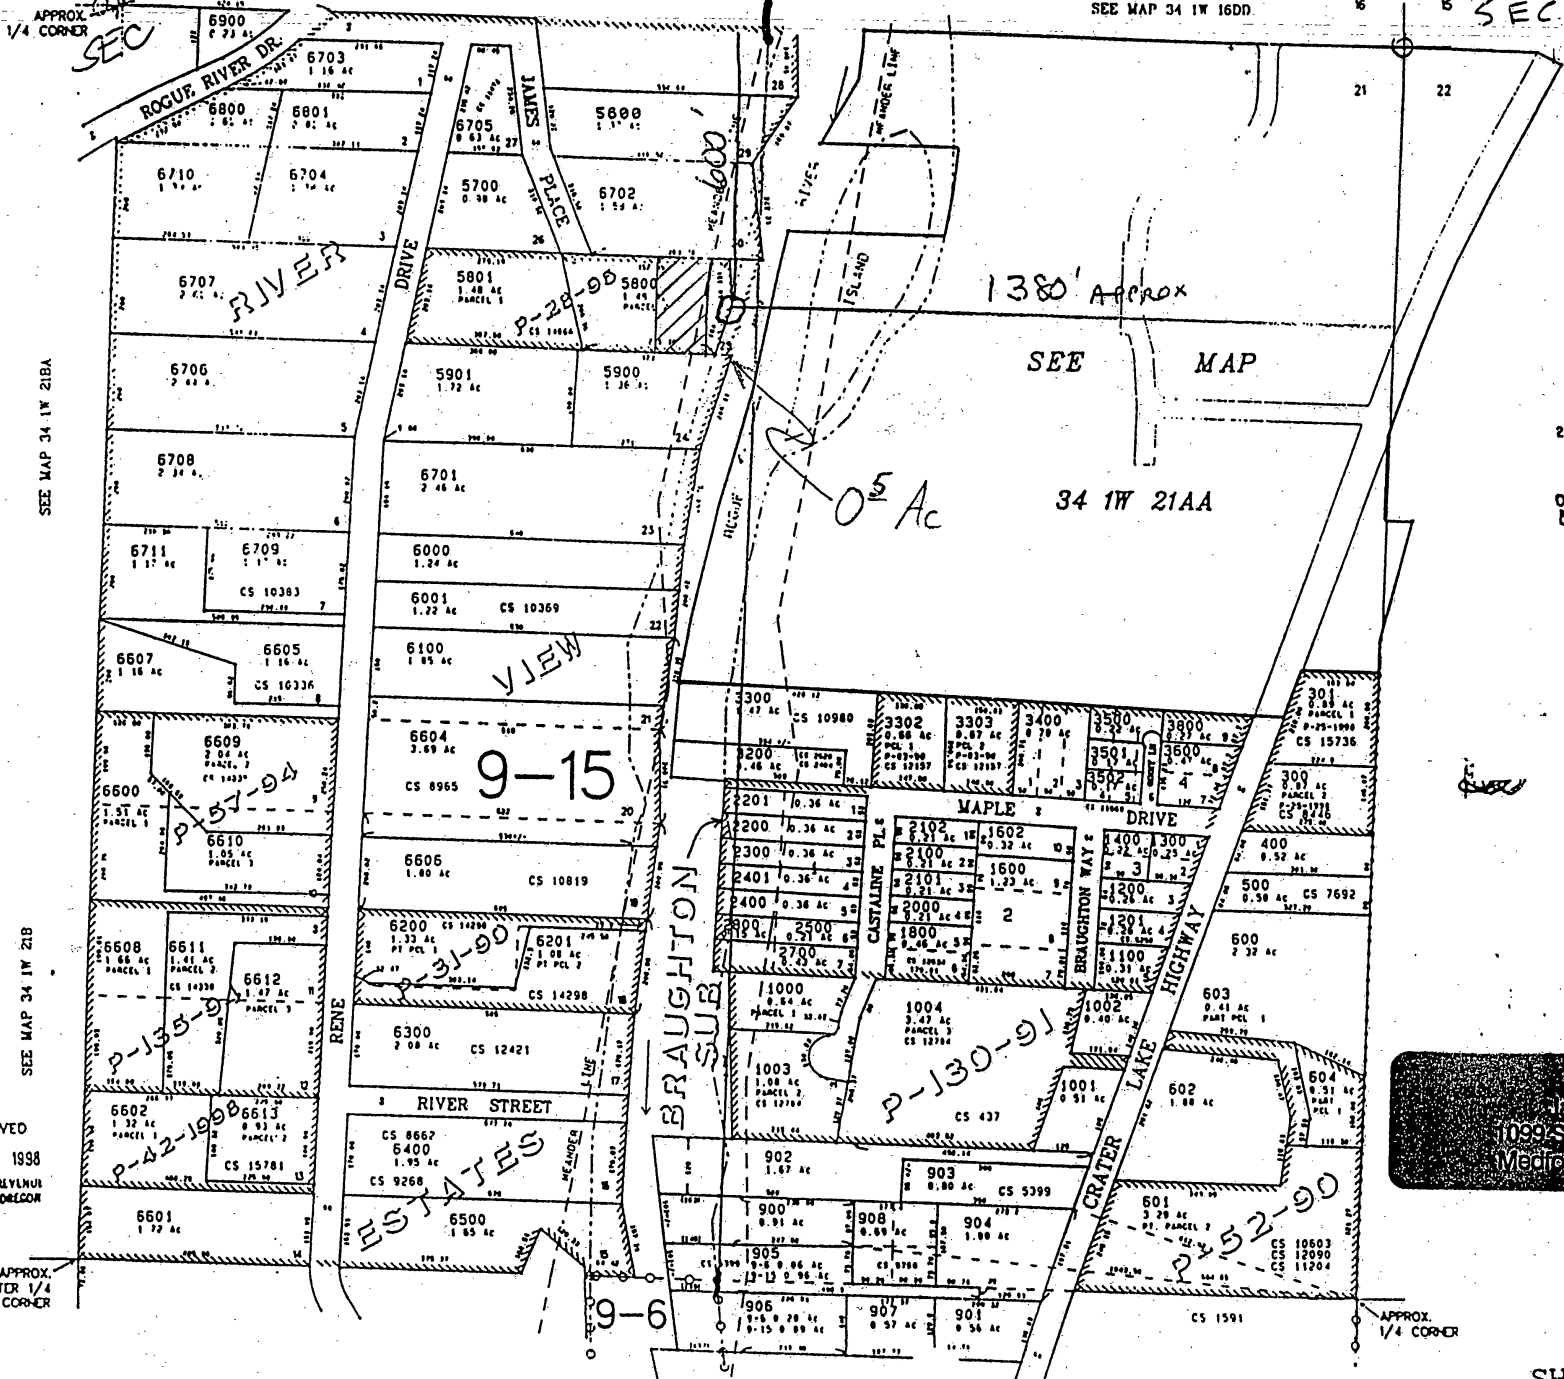

RECEIVED
AUG 11 1998
DEPT. OF REVENUE
STATE OF OREGON

APPROX.
CENTER 1/4
CORNER

SEE MAP 34 1W 21B

SEE MAP 34 1W 21B

APPROX.
1/4 CORNER