

NOV. 9 2000  
WATER RESOURCES DEPT  
SALEM, OREGON

JAN - 3 2001

WATER RESOURCES DEPT  
SALEM, OR

8 9  
17 16


2-31

Polk County


T. 7 South  
R. 4 West  
Sections 17 & 20  
W E  
S

112497  

Application No. S8462  
Permit No. S-53800

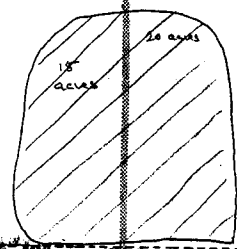

13-40

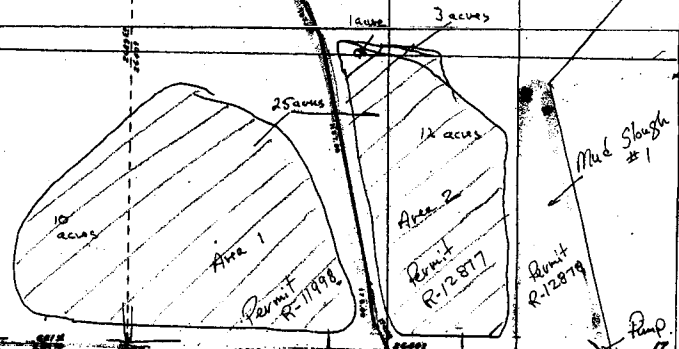

13-40

Mud Slough #1  
Area 1  
Area 2  
Major Pond Areas outlined in Blue

Pod 2-31

Pump Site  
255 ft West  
30 ft North  
of SE corner of Section 17

