


cen. sec.

Scale: 1" = 500'

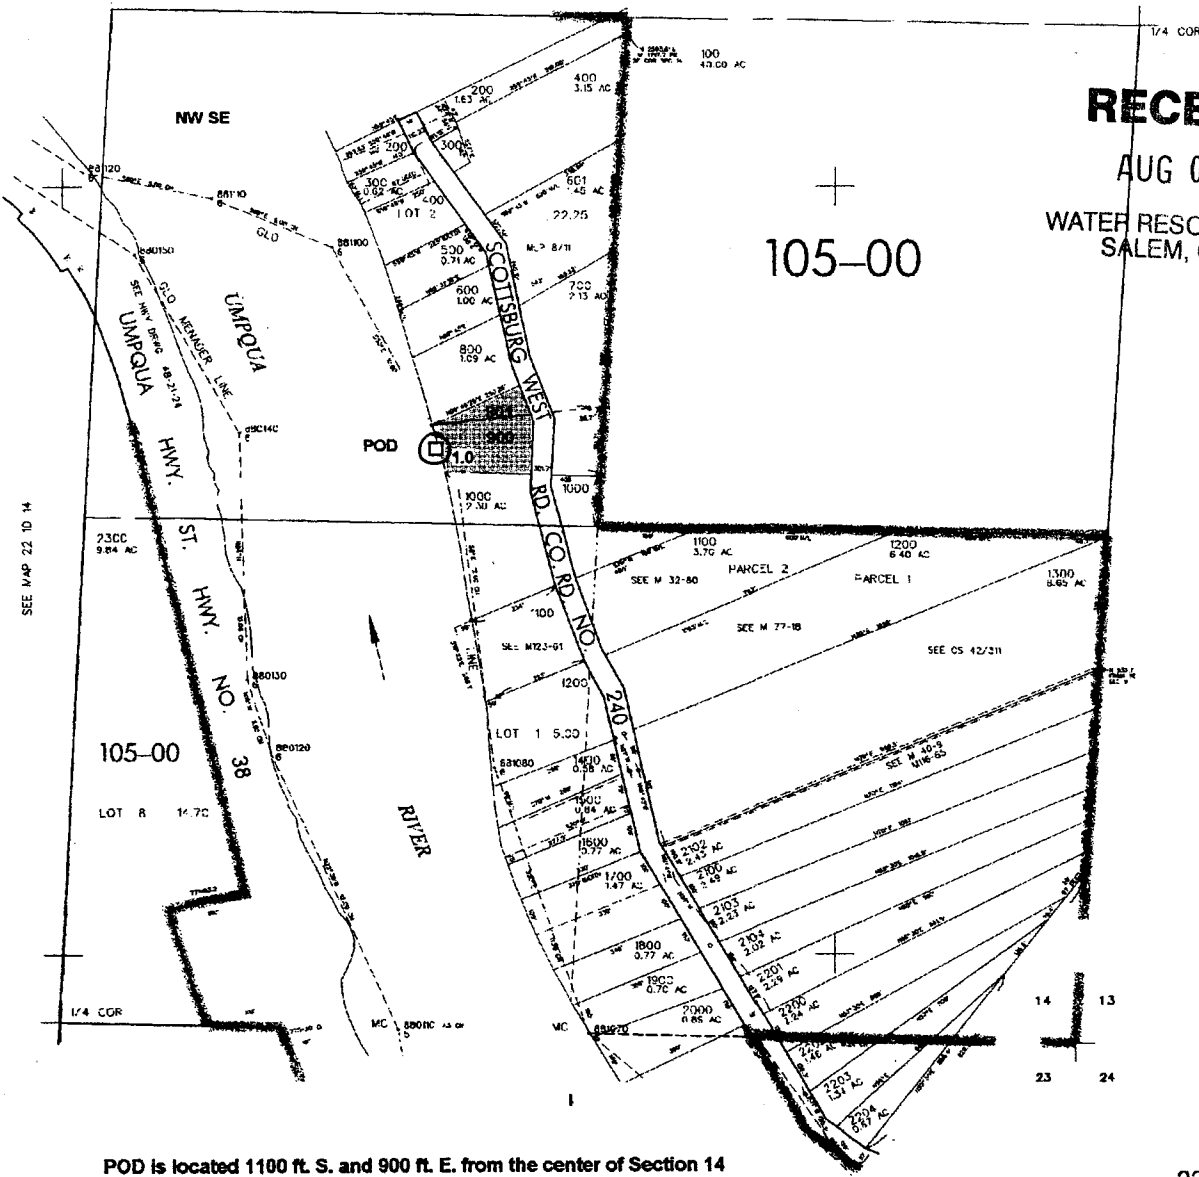

RECEIVED

AUG 06 2001

WATER RESOURCES DEPT.
SALEM, OREGON

105-00

POD is located 1100 ft. S. and 900 ft. E. from the center of Section 14

Application No. 84834
Permit No. S-53820