
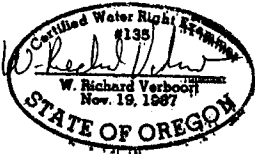


Application No. S-85DI17
 Permit No. S-53826

NW1/4 SEC. 35 T.3N. R.1W. W.M.
 MULTNOMAH COUNTY

1" = 200'

44.8 AC
 TOTAL

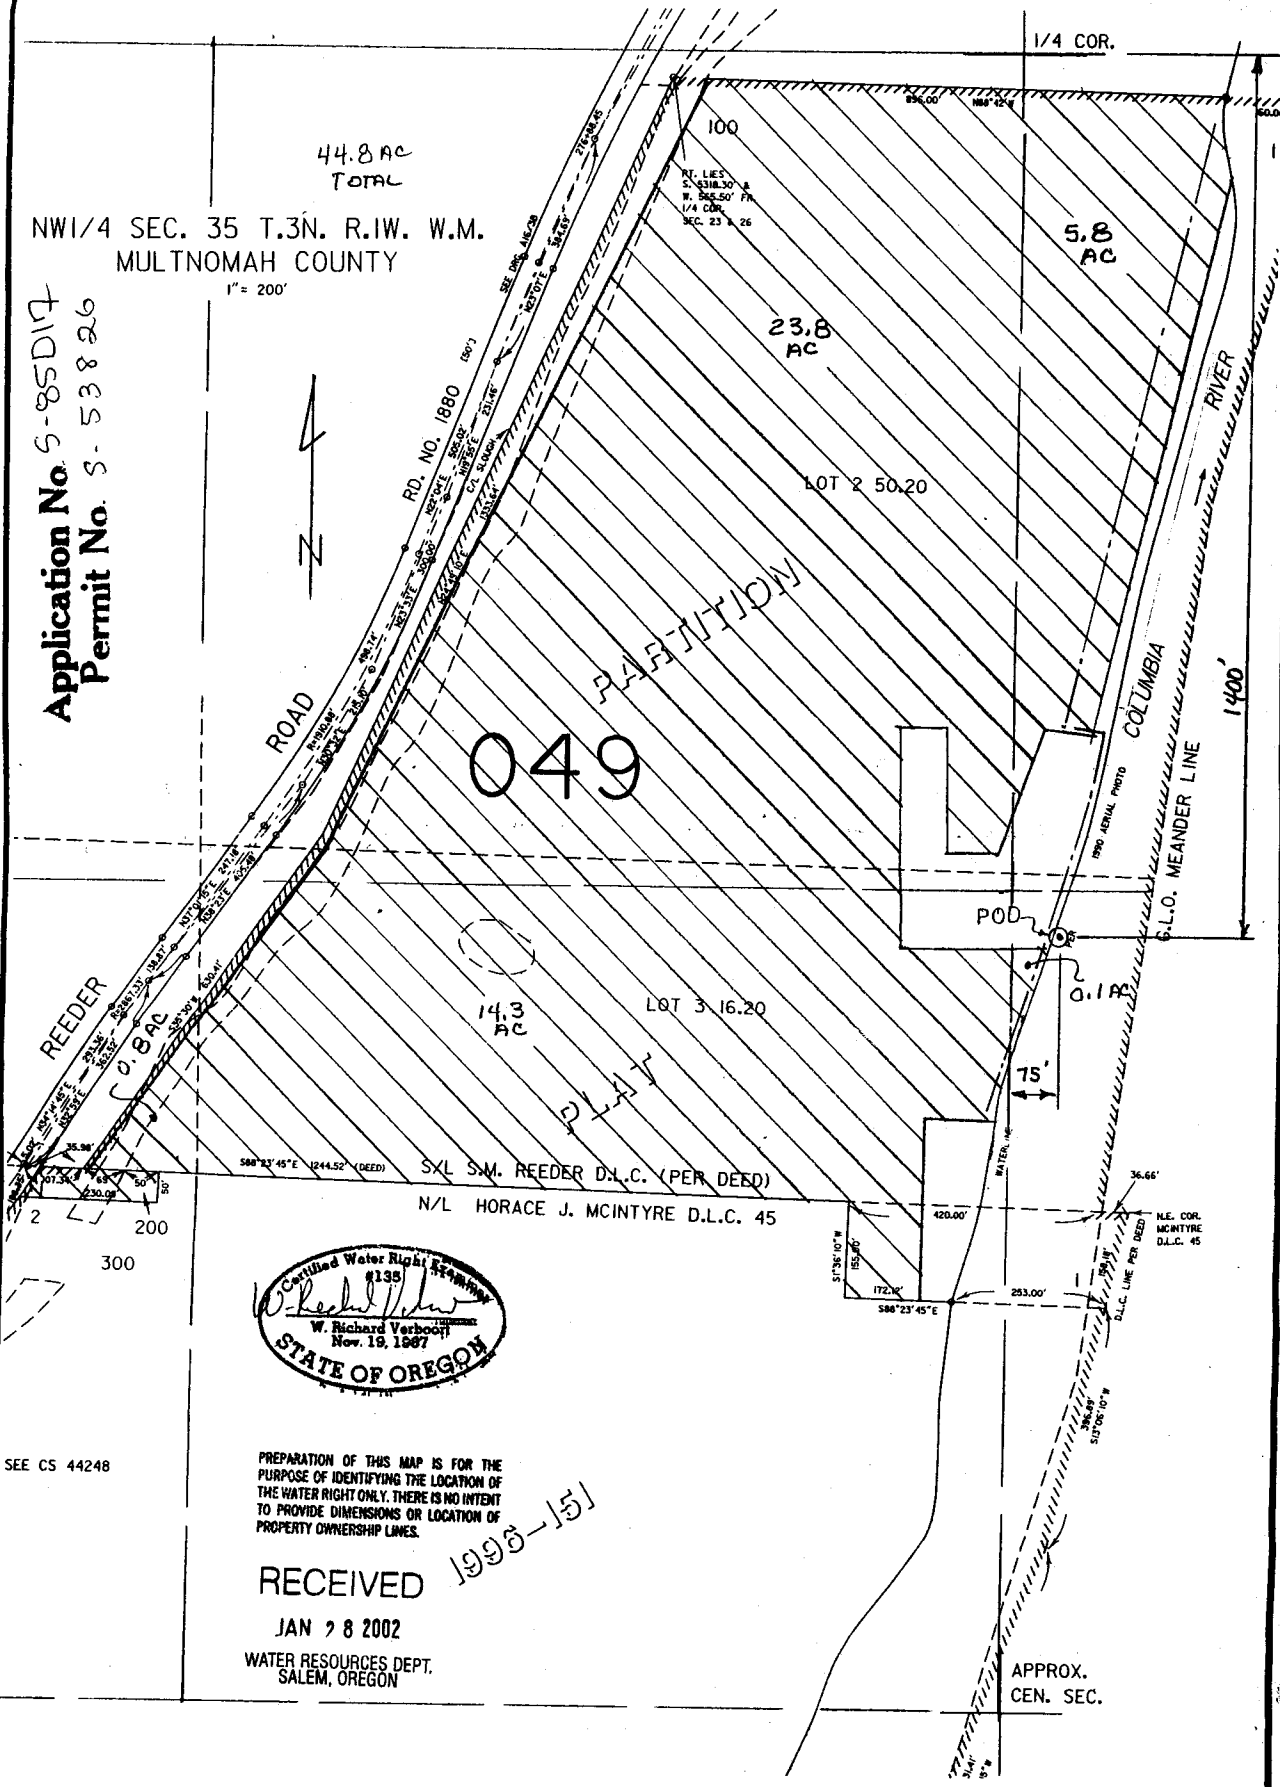

PREPARATION OF THIS MAP IS FOR THE
 PURPOSE OF IDENTIFYING THE LOCATION OF
 THE WATER RIGHT ONLY. THERE IS NO INTENT
 TO PROVIDE DIMENSIONS OR LOCATION OF
 PROPERTY OWNERSHIP LINES.

RECEIVED

JAN 28 2002

WATER RESOURCES DEPT.
 SALEM, OREGON

1998-151

SEE CS 44248

VERBOORT ENGINEERING
 AGRICULTURE • CIVIL • WATER RESOURCES
 HILLSBORO, OREGON

	by	date
designed	WRV	01-10-02
drawn	WRV	01-02
checked		
drawing no.	02-B-01	
sheet no.	1	

WATER RIGHT APPLICATION
 for
 RANDY RUST & LAURA RUST
 P.O. BOX 119
 GRAYLAND, WA 98547