


T. 28 S., R. 6 W., SEC. 3 W. M.

Scale: 1" = 250'

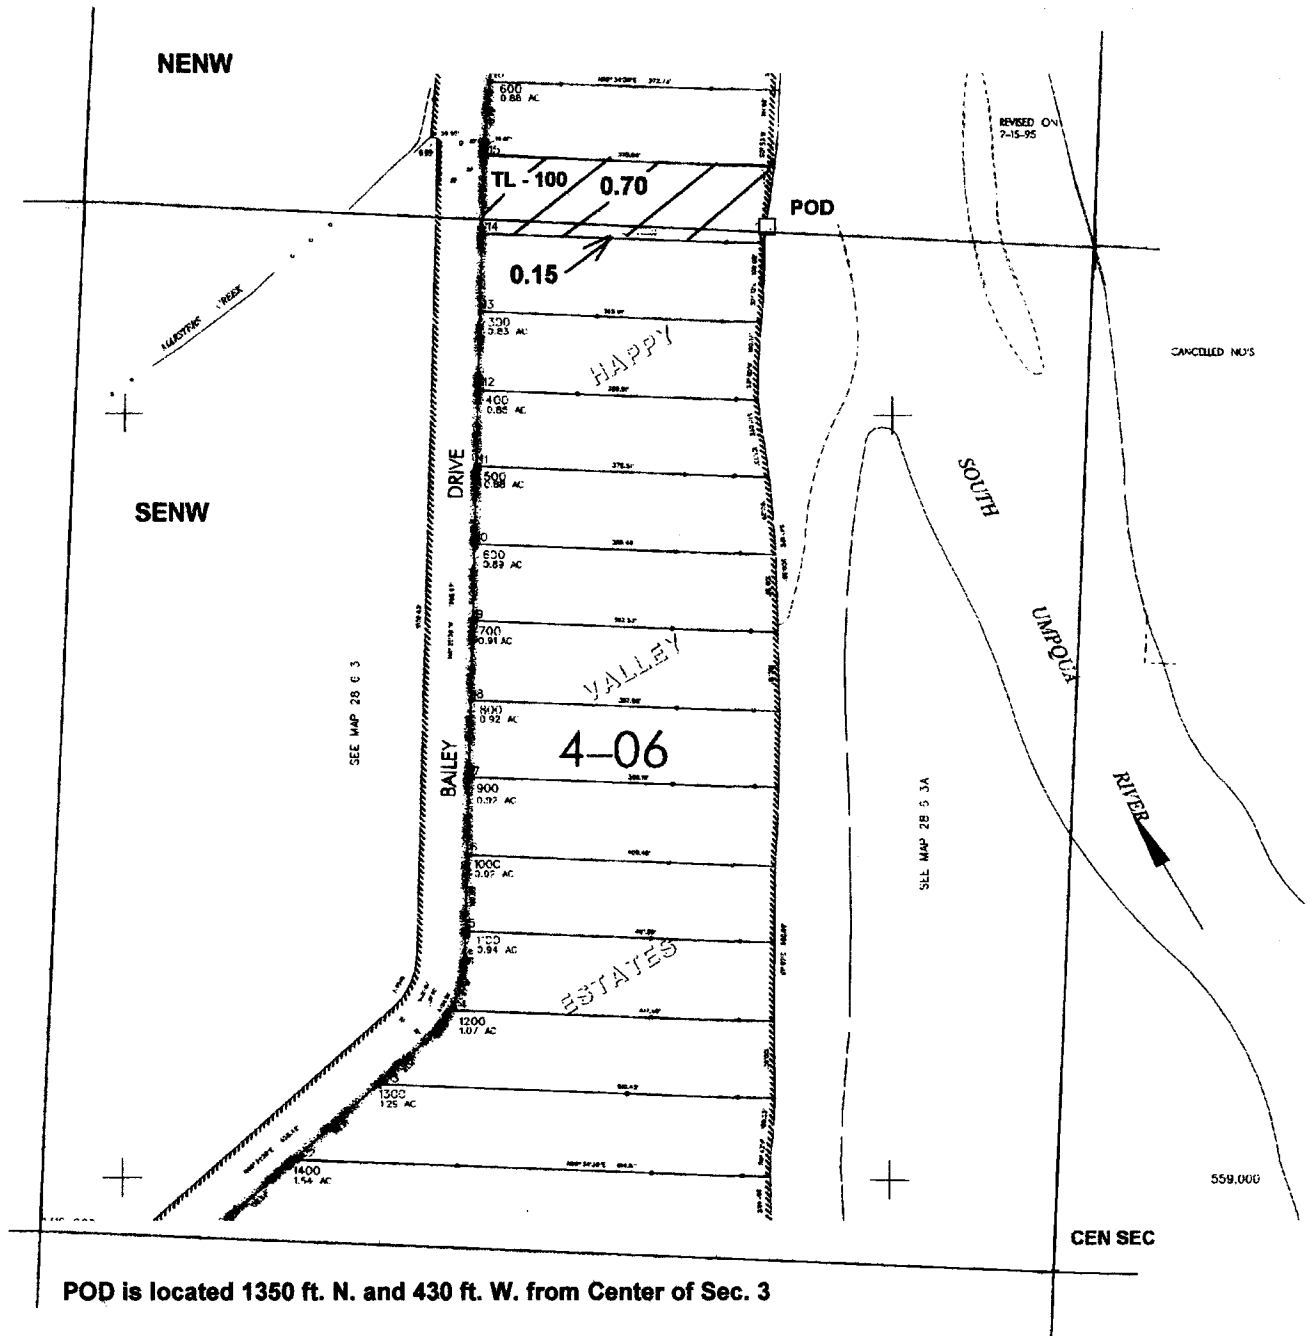

Application No. 5-85059
Permit No. S-53840

RECEIVED

FEB 20 2002

WATER RESOURCES DEPT.
SALEM, OREGON