


FOR CLAYTON AND MYRNA JUDD  
SURVEY OCTOBER 19, 2001  
BY DUANE KIRBY  
T25S, R7W, W.M.  
SECTION 21, TAXLOT 600  
SCALE: 1" = 400'


RECEIVED  
JUN 04 2002  
WATER RESOURCES DEPT.  
SALEM, OREGON

RECEIVED  
OCT 25 2001  
WATER RESOURCES DEPT. 16 15  
SALEM, OREGON

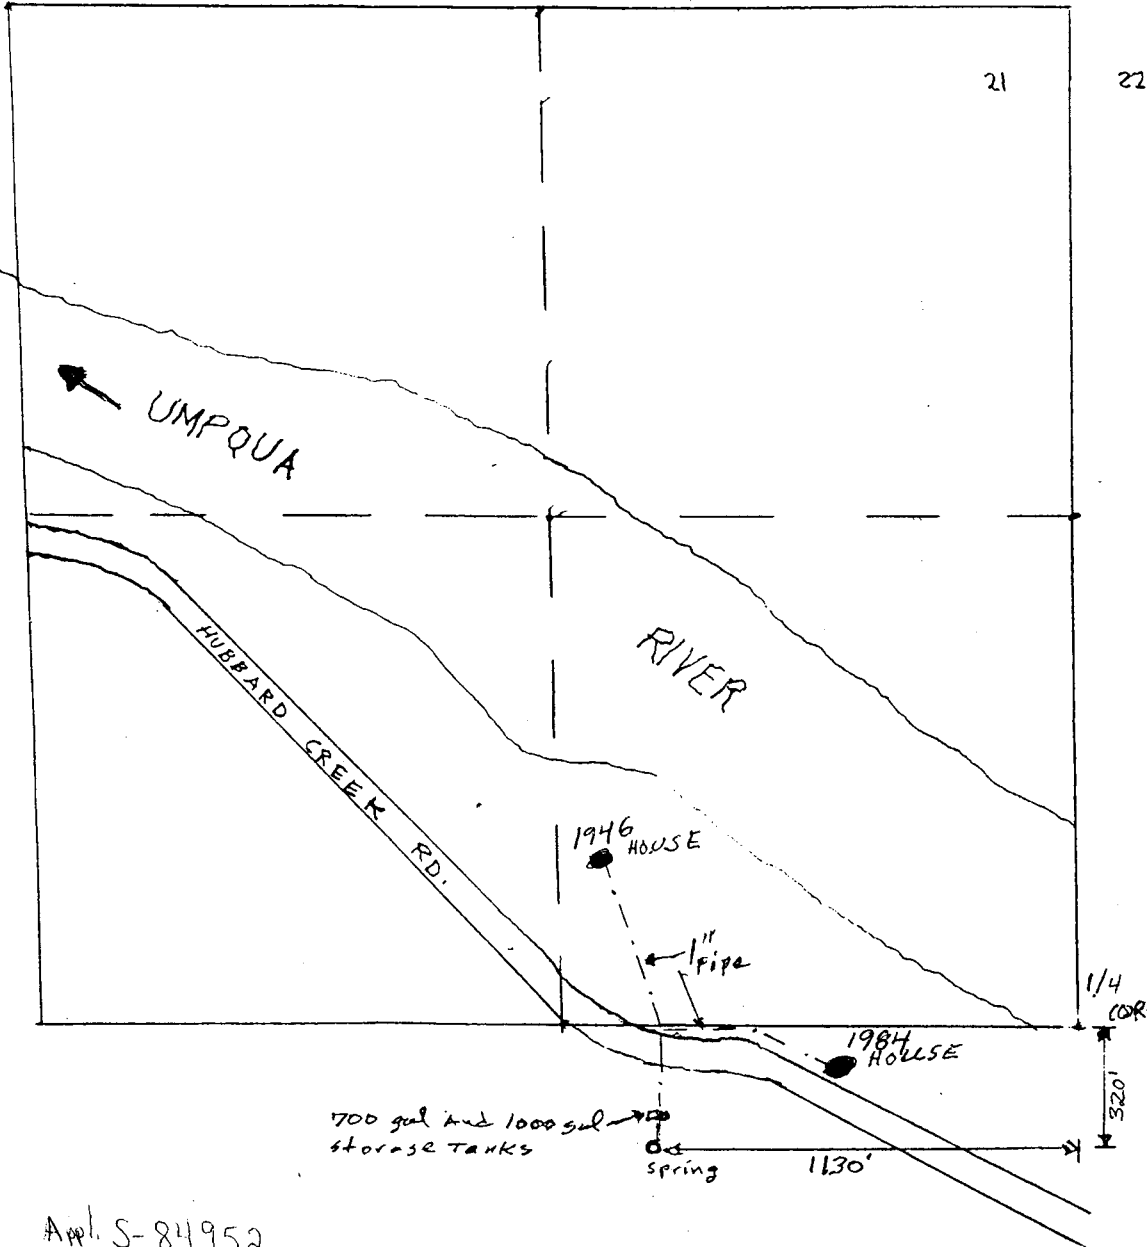

App. S-84952

THE PURPOSE OF THIS MAP IS TO IDENTIFY THE LOCATION OF THE WATER RIGHT. IT IS NOT INTENDED TO PROVIDE LEGAL DIMENSIONS OR THE LOCATION OF PROPERTY OWNERSHIP LINES.

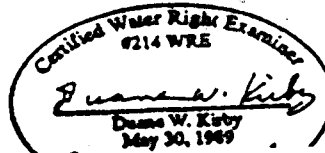

App # S-84952  
Permit # S-53891