


Application No. S-85061

Permit No. S-53892

T.9S. R.1E. Sec. 15 & 22

RECEIVED
FEB 21 2002
WATER RESOURCES DEPT
SALEM, OR

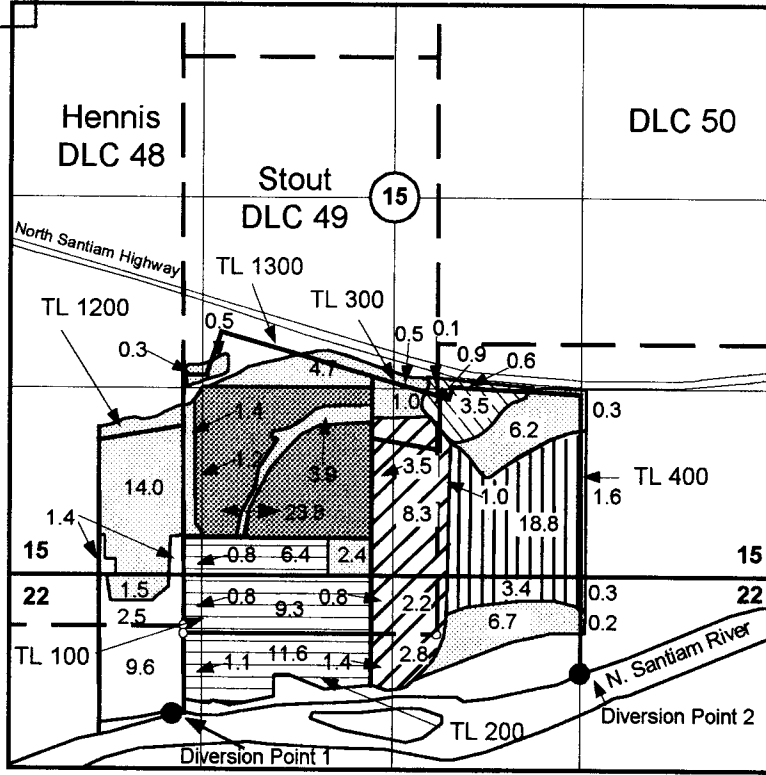


CERTIFIED WATER RIGHTS EXAMINER
#60772WRE
Malia R. Kuppilas
MALIA R. KUPILLAS
JUNE 28, 1999
STATE OF OREGON

EXPIRATION DATE: 6/30/03

Diversion Point 1 is located 550 feet south and 87.5 feet west of the southwest corner of Stout DLC 49.
Diversion Point 2 is located 250 feet south and 2750 feet east of the southwest corner of Stout DLC 49.

- Area (30.0 Acres) irrigated under Application S-23801, Permit S-18817, Certificate 24108, Transfer T-6870. Priority date 5/23/1949. Source is Santiam River at 0.38 cfs.
- Area (20.0 Acres) irrigated under Application S-33572, Permit S-26562, Certificate 30017, Transfer T-6870. Priority date 1/26/1960. Source is Santiam River at 0.25 cfs.
- Area (25.0 Acres) irrigated under Application S-41909, Permit S-31373, Certificate 40590, Transfer T-6870. Priority date 2/23/1966. Source is Detroit Reservoir for 53.8 acre-feet of stored water.
- Area (24.1 Acres) irrigated under Application S-42254, Permit S-31614, Certificate 64092, Transfer, T-6870. Priority date 5/25/1966. Source is North Santiam River at 0.42 cfs.
- Area (13.5 Acres) irrigated under Application S-43423, Permit S-32464, Certificate 40457, Transfer T-6870 and Permit S-53184. Priority date 5/28/1967 and 2/2/1996. Source is Detroit Reservoir for 33.7 acre-feet of stored water.
- Area (43.6 Acres) irrigated under Application S-64841, Permit S-47553, Certificate 64168, Transfer T-6870, and Permit S-53184. Priority date 2/11/1983 and 2/2/1996. Source is Detroit Reservoir for 109 acre-feet of stored water.
- Area (5.1 Acres) irrigated under Application S-80916, Permit S-53184. Priority date 2/2/1996. Source is North Santiam River from 3/1 to 6/30 and Detroit Reservoir for 5.1 acre-feet of stored water.

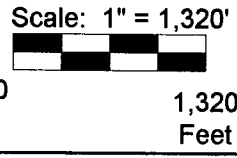

This map was prepared for the purpose of identifying the location of a water right only and is not intended to provide legal dimensions or location of property ownership lines.



Surface Water Right To Expand Existing Water Rights to Year Round Nursery

Krautmann Family Nursery, LLC
T.9 S. R.1E. Sec. 15 & 22

Pacific Hydro-Geology Inc.