


Scale: 1" = 500'

Application No 5-85198
Permit No S-53915¹⁰

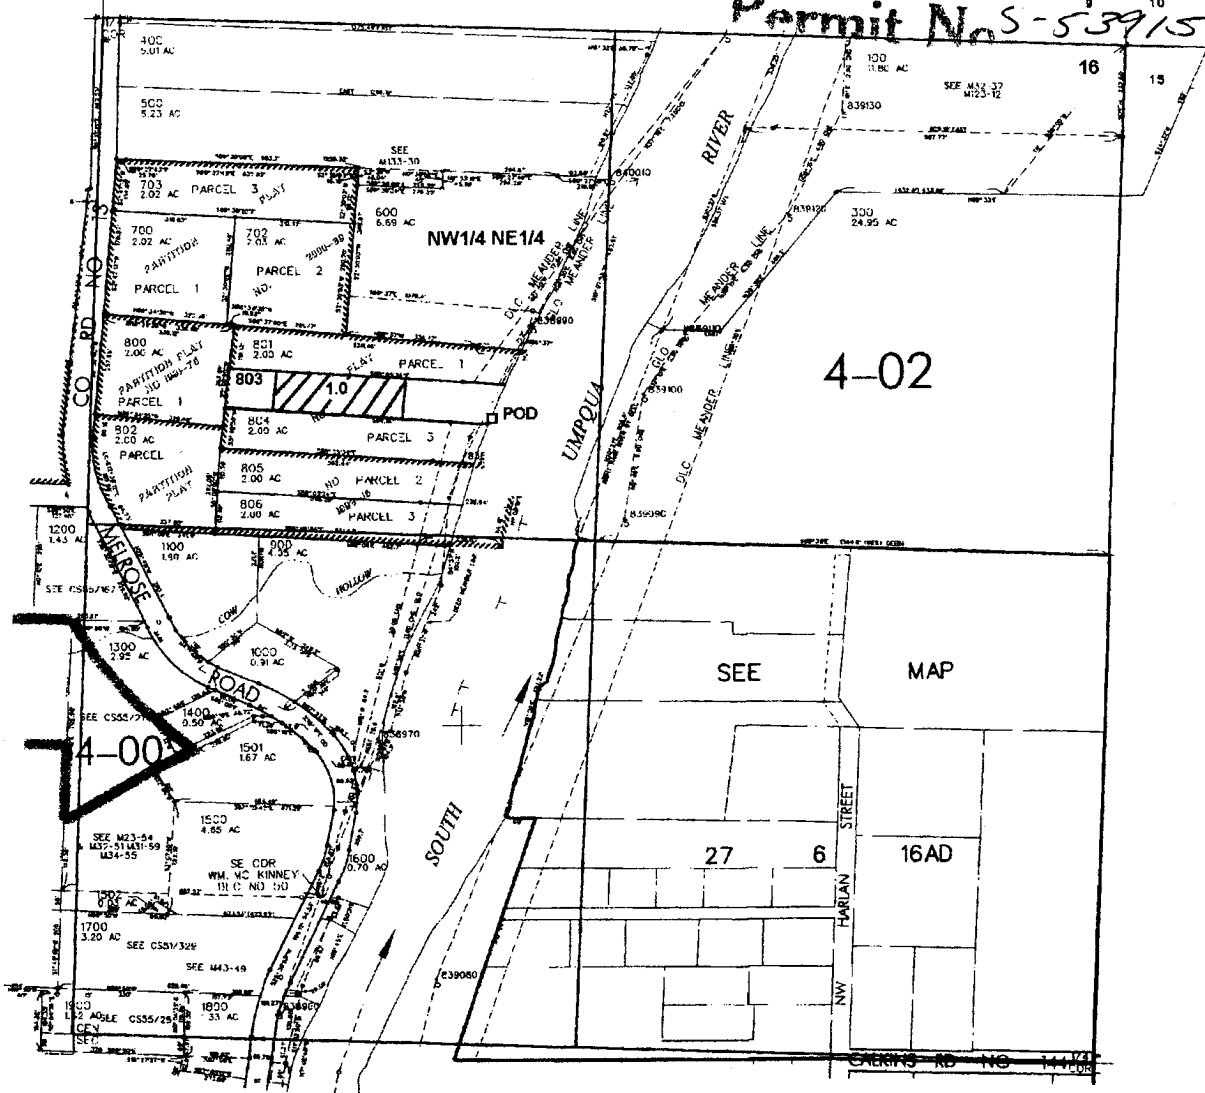

POD is located 1030 ft. S. and 1050 ft. E. from the N. 1/4 corner of Sec. 16

RECEIVED
JUN 04 2002
WATER RESOURCES DEPT.
SALEM, OREGON