
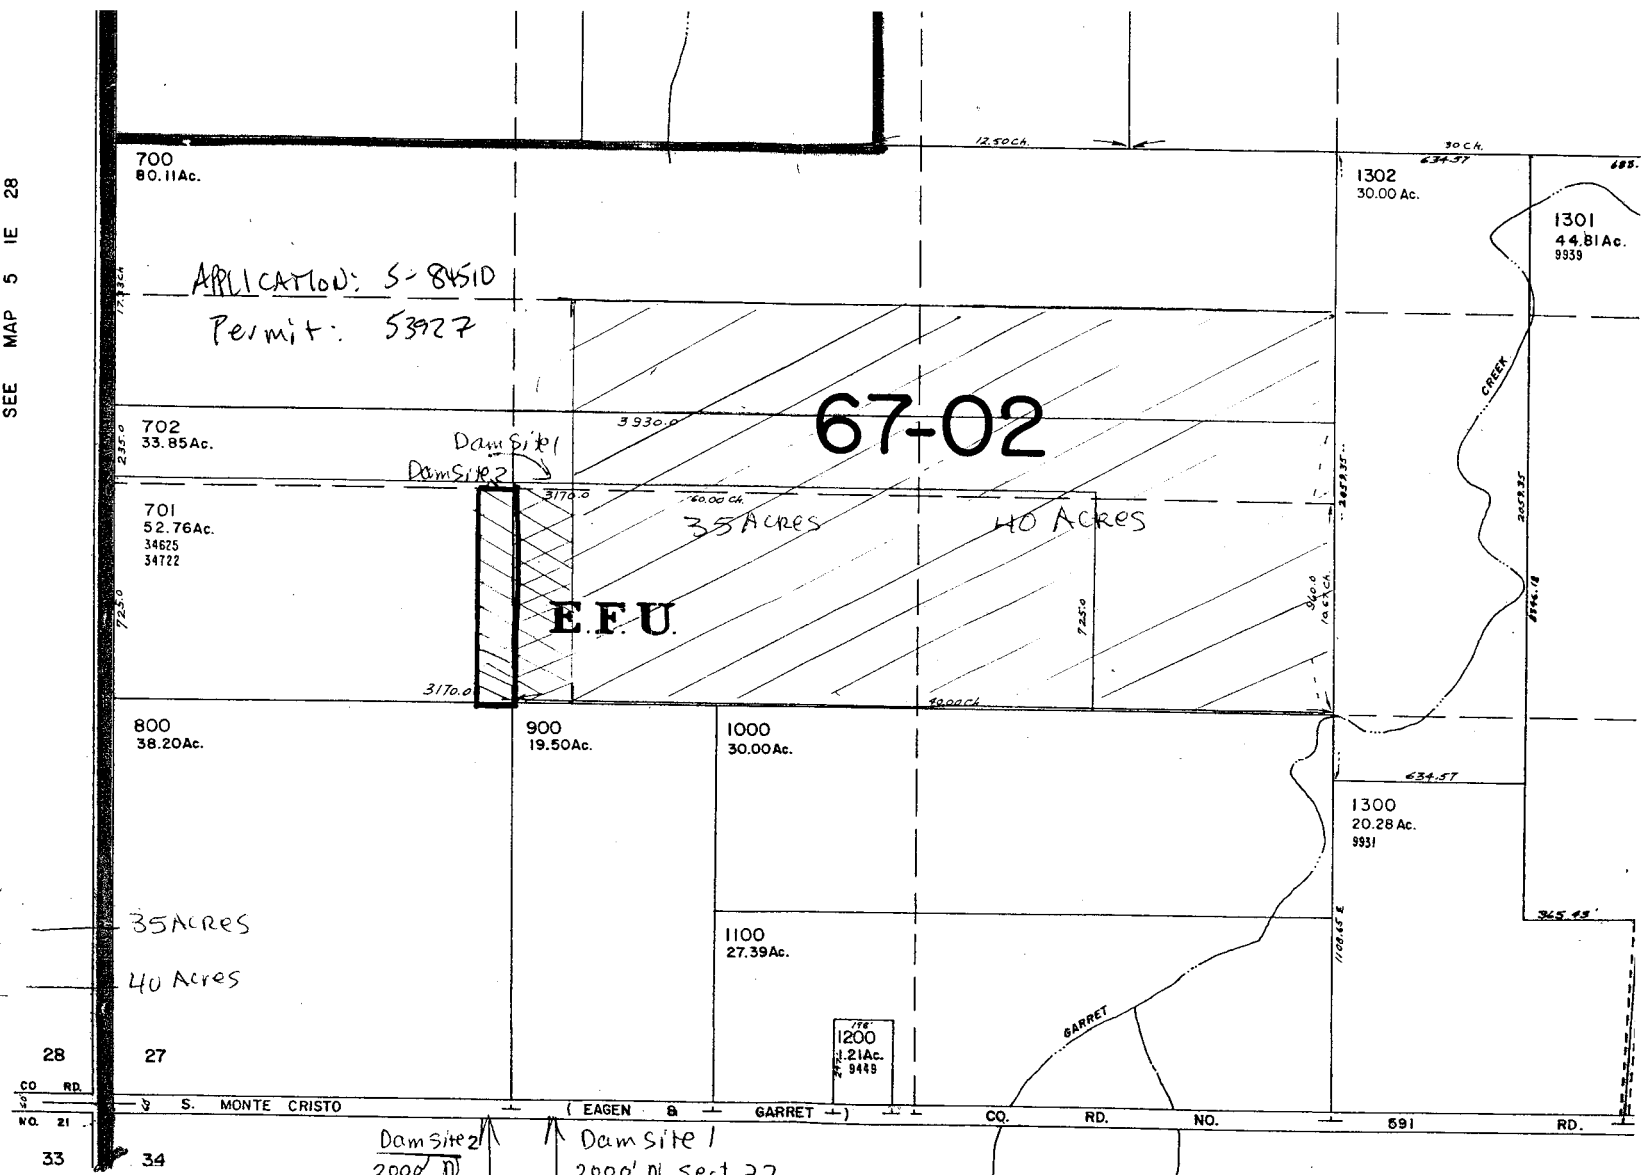
 Dam Site 1
 2000' N and 1400' E
 from SW corner of sect 27

 Dam Site 2
 2000' N and 1800' E
 from SW corner of sect 27

IRRIGATED Ground
 NE 1/4 of SW 1/4 55 E 27
 NW 1/4 of SE 1/4 55 E 27

SEE MAP 5 IE 28



28
 CO RD
 NO. 21
 33

S. MONTE CRISTO (EAGEN & GARRET) CO. RD. NO. 691 RD.

Dam Site 2
 2000' N
 Sect 27

Dam Site 1
 2000' N sect 27

SEE MAP 5 IE 34

app # S-84510
 Permit # S-53927