
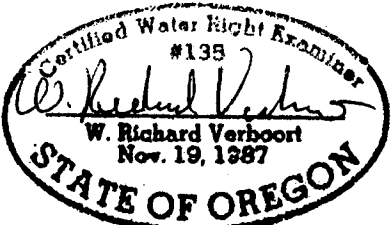


Application No. 5-85254
 Permit No. 5-53943

T3S R4W W.M.

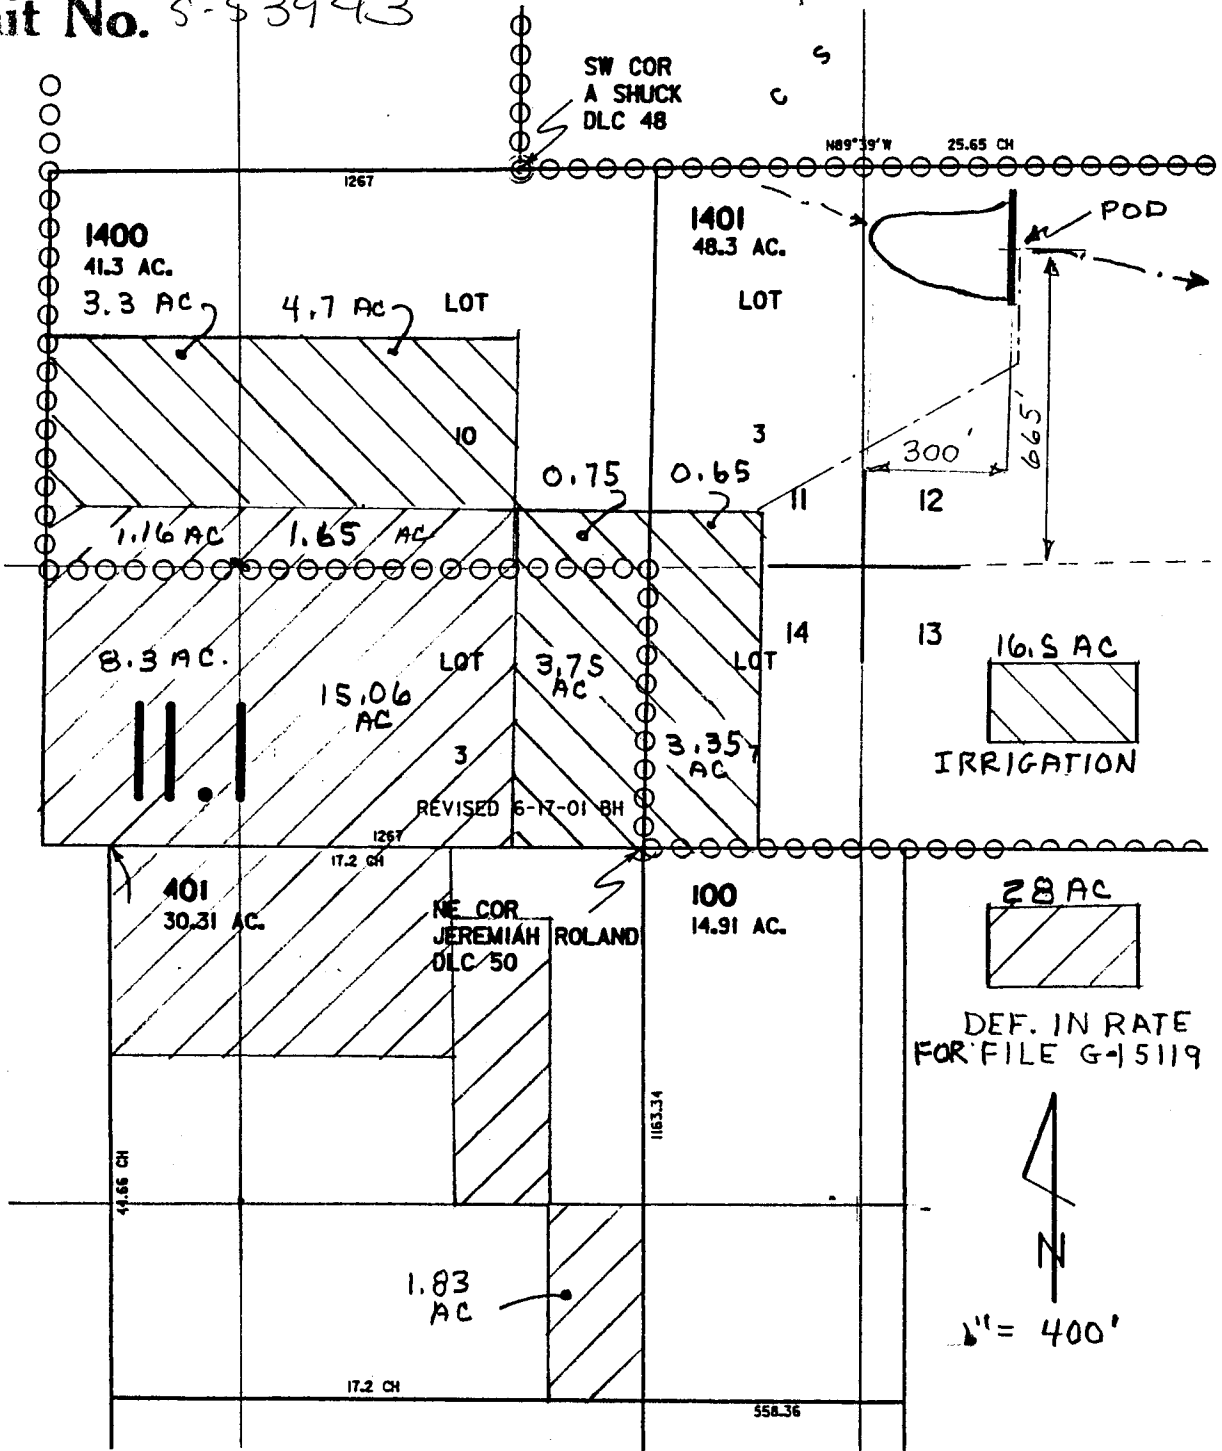

RECEIVED

JUL 30 2002

WATER RESOURCES DEPT.
 SALEM, OREGON

PREPARATION OF THIS MAP IS FOR THE PURPOSE OF IDENTIFYING THE LOCATION OF THE WATER RIGHT ONLY. THERE IS NO INTENT TO PROVIDE DIMENSIONS OR LOCATION OF PROPERTY OWNERSHIP LINES.

VERBOORT ENGINEERING
 AGRICULTURE · CIVIL · WATER RESOURCES
 HILLSBORO, OREGON

	by	date
designed	RV	7-02
drawn	---	---
checked	---	---
drawing no.	02-A-03	
sheet no.	1/1	

ERIC LEMELSON
 12020 NE STAG HOLLOW ROAD
 CARLTON, OR 97111