


THIS MAP WAS PREPARED FOR
ASSESSMENT PURPOSES ONLY

NW 1/4 SEC. 18 T36S R2W WM.
JACKSON COUNTY

1" = 400'

36 2W 18B

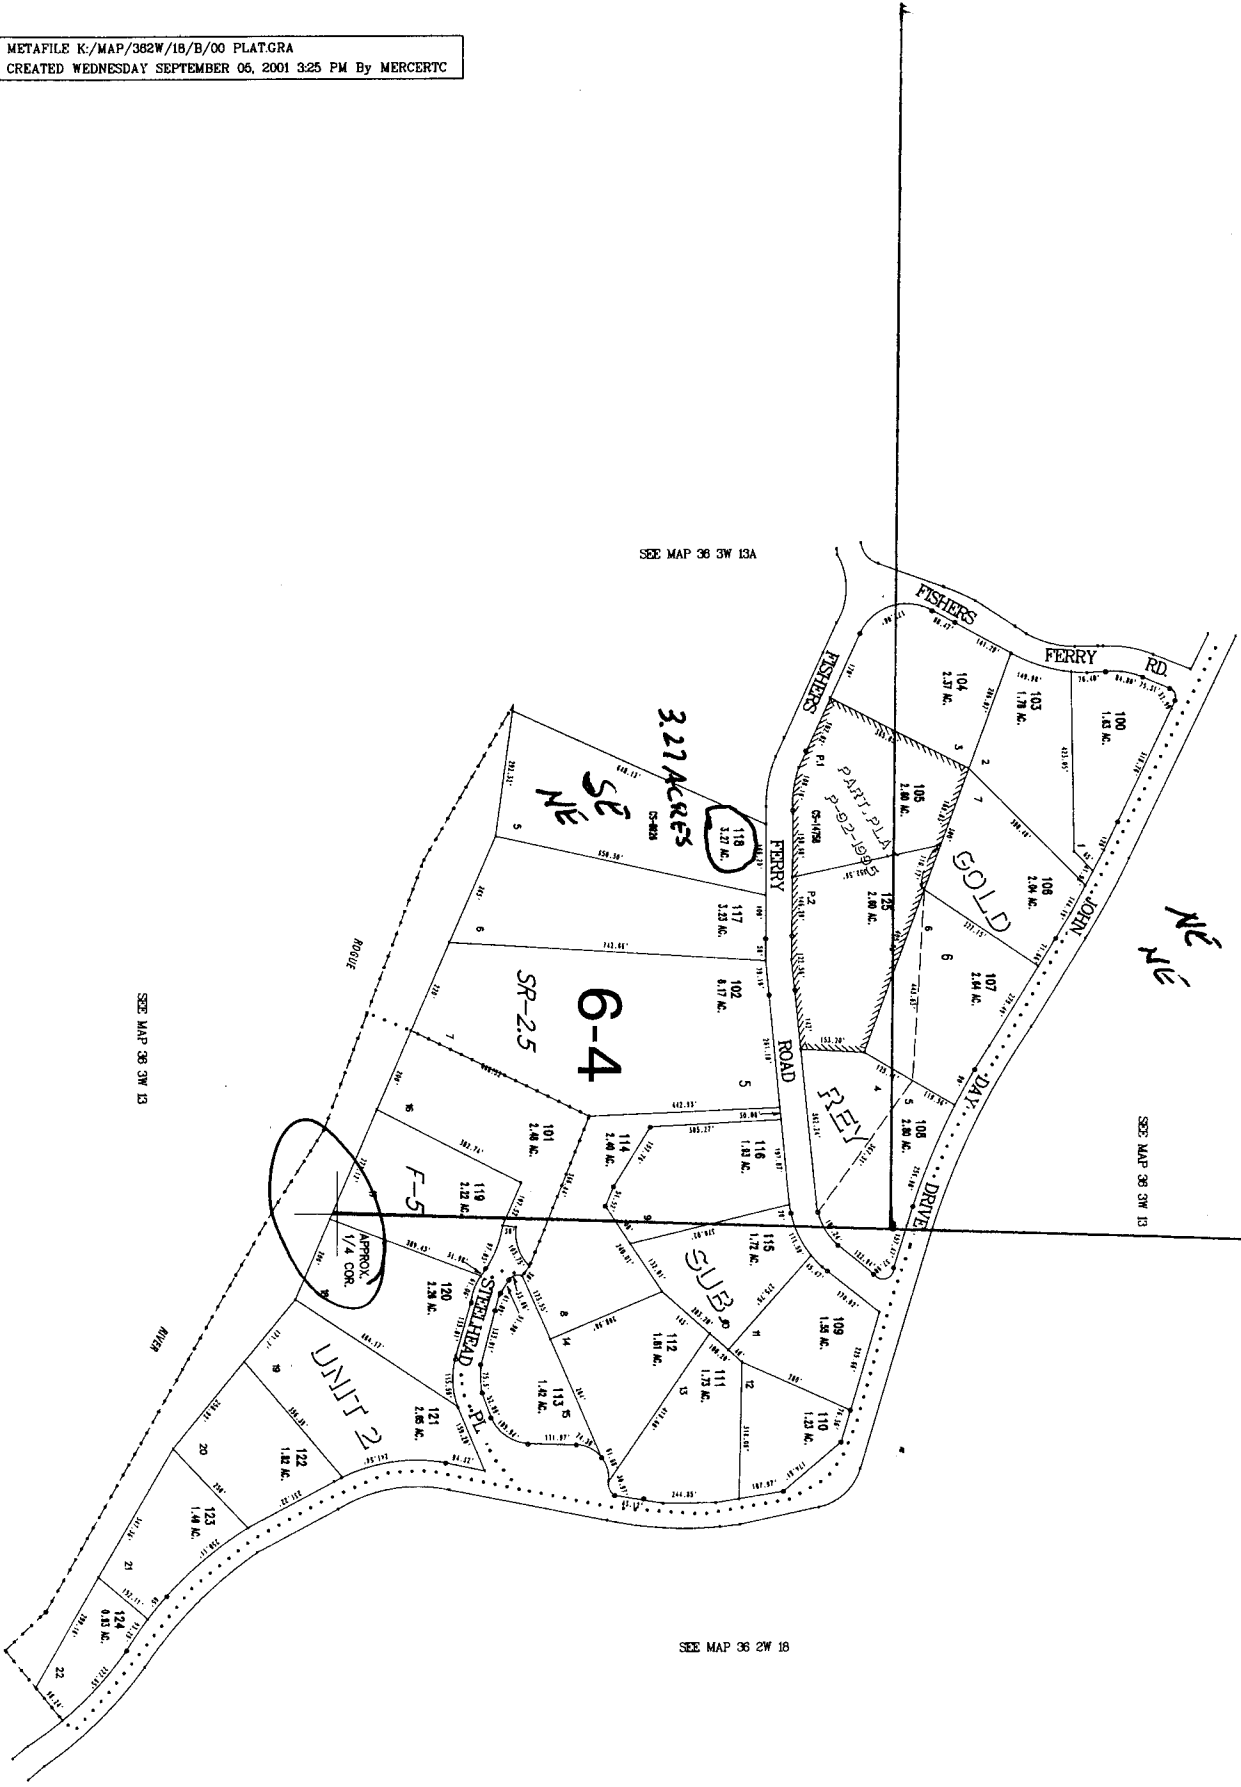

SEE MAP 36 3W 13A

SEE MAP 36 3W 13

SEE MAP 36 3W 13

SEE MAP 36 2W 18

36 2W 18B
DNR CONVERSION PLAT 382