


Permit: S 5395
Volume: 7
Strm: CARIS CR
Trib: APPLEGATE R
Priority: 4/01/22

T.37S., R.4W., W.....

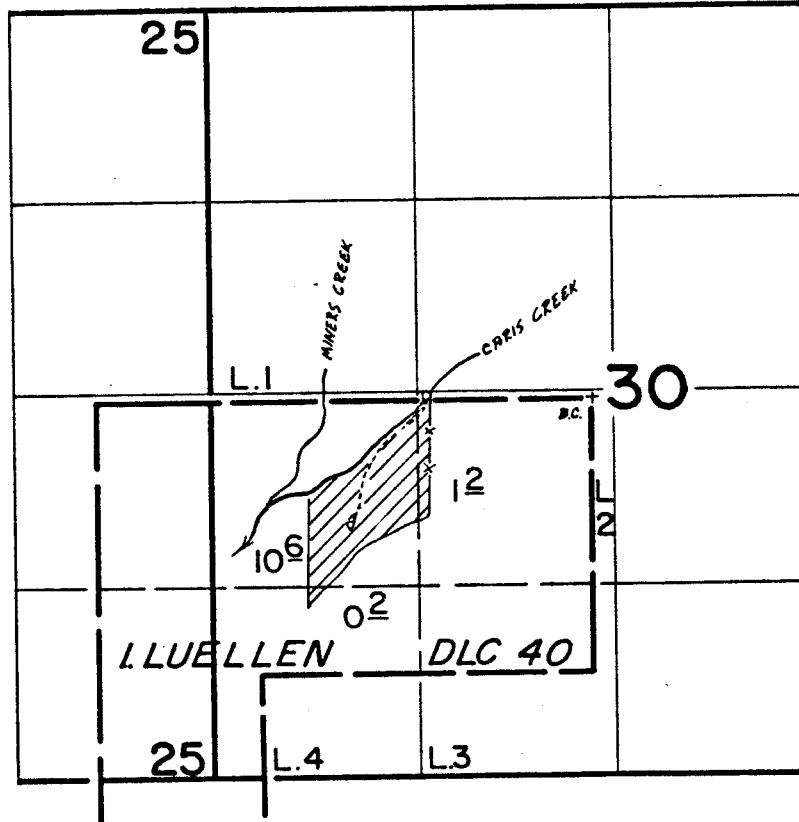

Scale 1"=1320'

REMAINING
RIGHT.

[REDACTED]

RECEIVED

JAN 27 1986

WM. DIST. 14
GRANTS PASS, ORE.

Application No. 8324.... Permit No. 5395.....
IN NAME OF

.....
Surveyed Sept. 4, 1985, by B.S. JAMES.....

41029-179-115 L

ba