

FOR ASSESSMENT
AND TAXATION
ONLY

NE1/4 NW1/4 SEC. 34 T.19S. R.12W. W.M.
LANE COUNTY

*WORKING
COPY*


SCALE 1" = 100'
1" = 200'
SEE MAP 19 12 27 30

DATE	REVISION	EMPLOYEE
11-28	REV MAP TO CAD SYSTEM	
12-27	CHANGE FROM 100' TO 200'	
12-27	ADJUST STREET WIDTH TO 12'	
12-27	REPLACE 1/4 COR. WITH 1/4 COR.	
12-27	REPLACE 1/4 COR. WITH 1/4 COR.	
19 12 34 21
WESTLAKE

C.A.D. SYS.

App#
S-85575
Permit#
S-53968

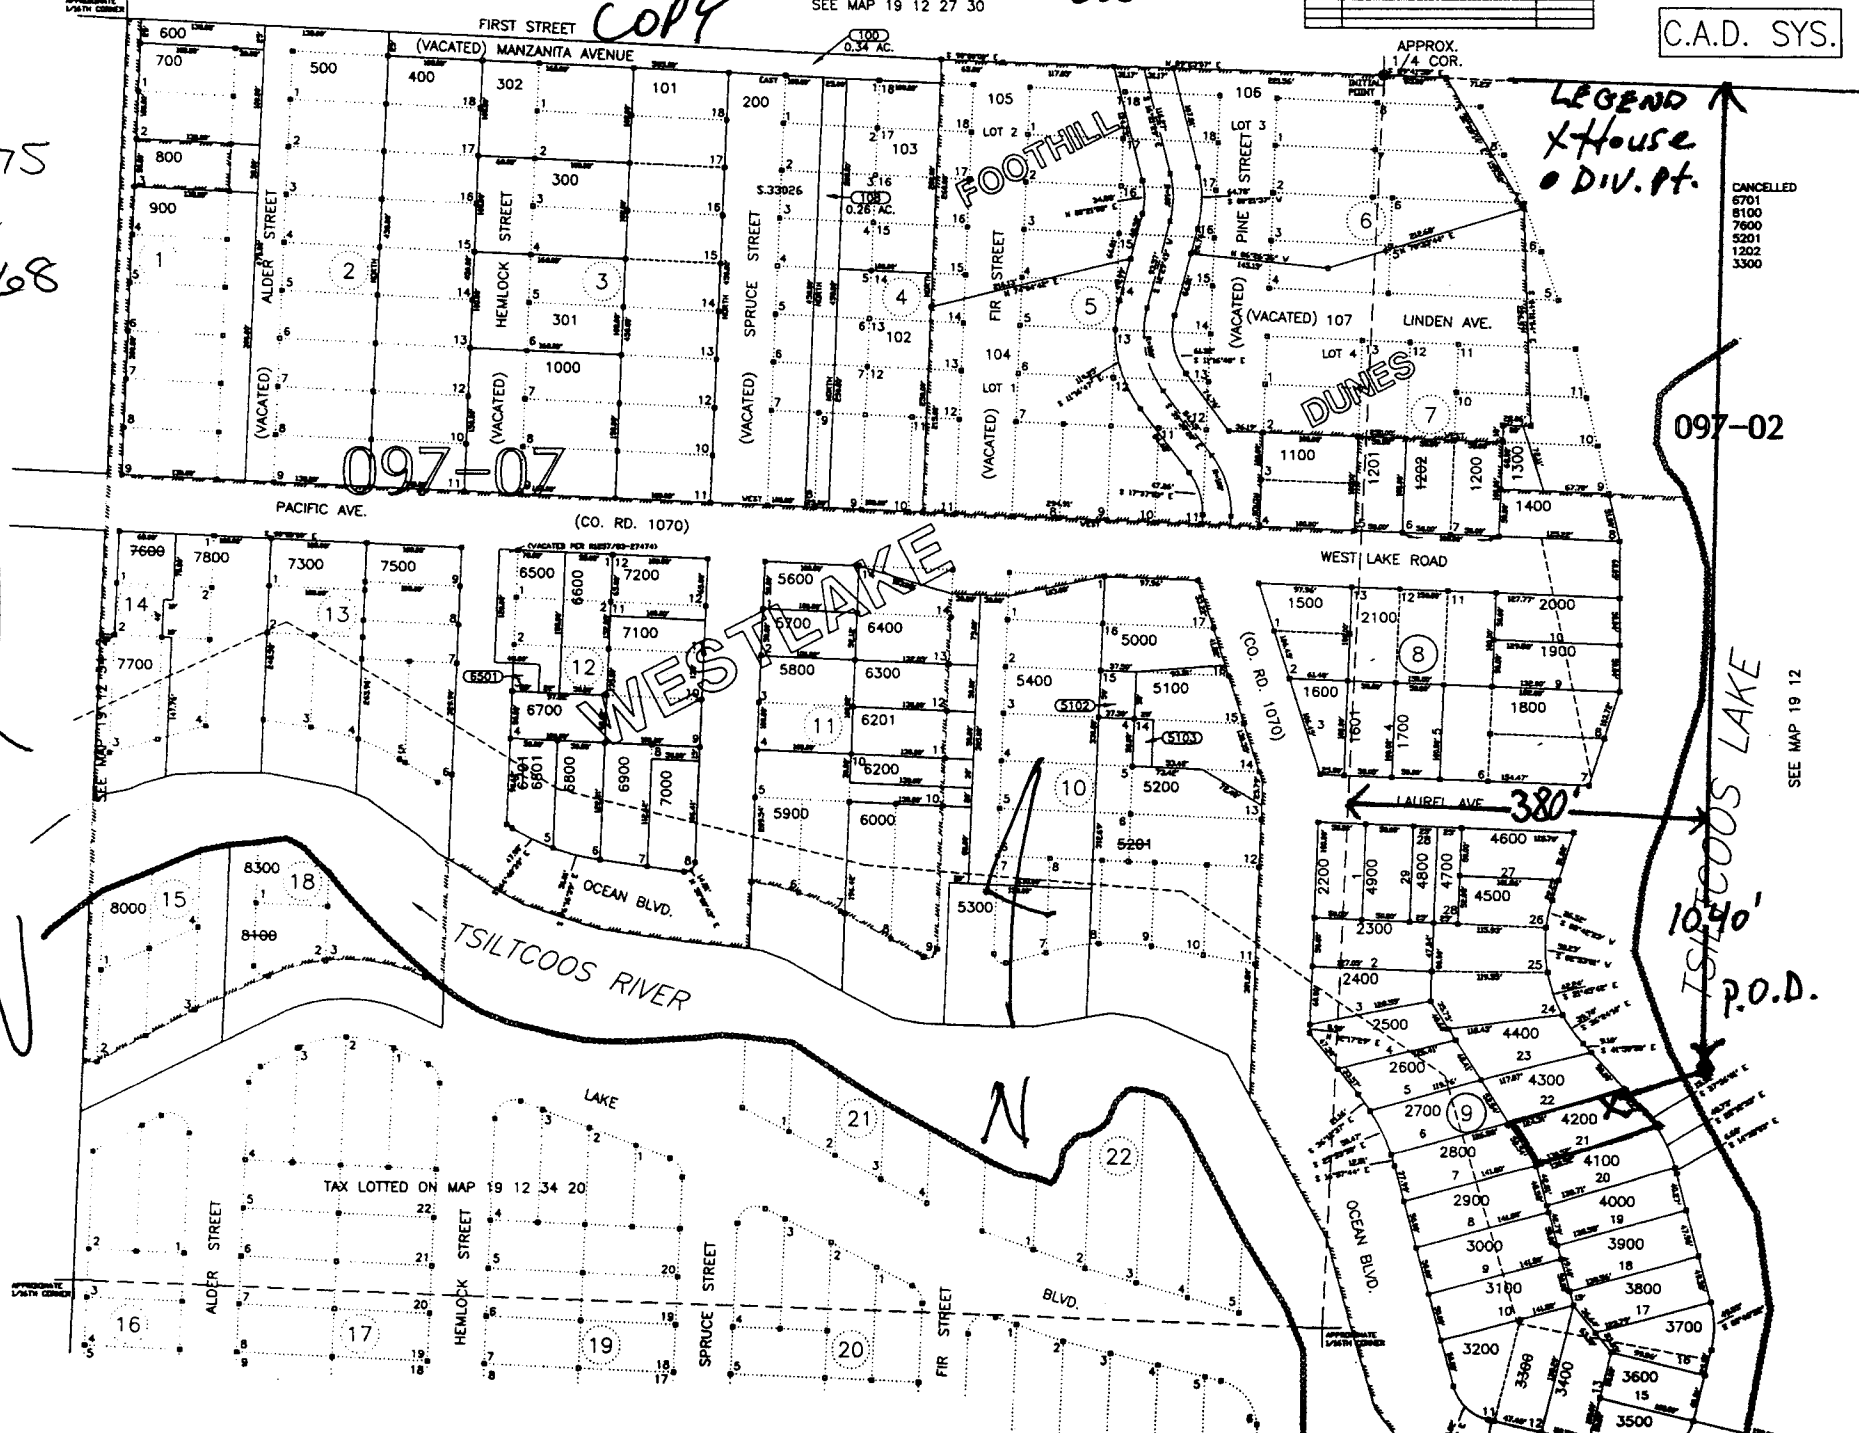

CANCELLED
6701
6100
7600
5201
1202
3300

SEE MAP 19 12

097-02

097-07

1040'
P.O.D.

TAX LOTTED ON MAP 19 12 34 20