

1" = ~~200~~
400

6009

6300

6500

SEE MAP 4 IE 31

1/4 COR.	<u>29500</u>
----------	--------------

29700


SEE MAP 4 IE 31

86-32

30000

WORK
COPY

DAM LOC:
650' N &
1250' E FROM
SW COR, SEC 31.

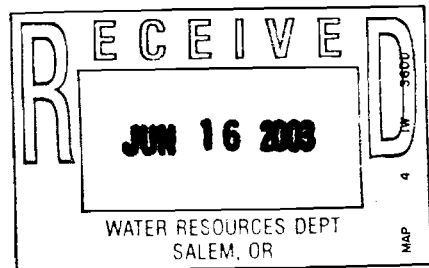

app no S-85253
Permit no S-53973

