


RECEIVED

SEP - 4 1997


WATER RESOURCES DEPT.
F. HALL, CHIEF

T. 5 N., R. 36 E., W.M.

WEST ALT POND
LOCATED FROM WEST 1/4 CORNER
SECTION 19, 875 FT NORTH &
250 FT EAST

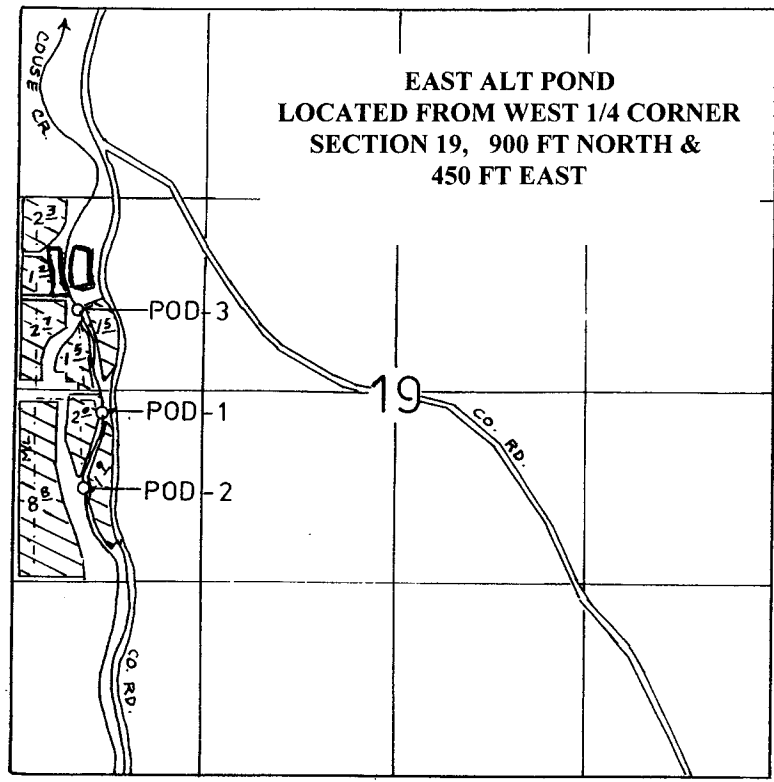

EAST ALT POND
LOCATED FROM WEST 1/4 CORNER
SECTION 19, 900 FT NORTH &
450 FT EAST

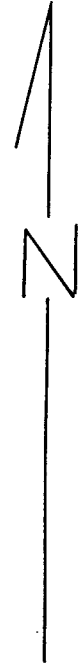

1" = 1320'

POD 1 - 150' S. & 610' E.
 POD 2 - 660' S. & 500' E.
 POD 3 - 550' N. & 430' E.
 ALL FROM THE W 1/4 COR. SEC. 19

FINAL PROOF SURVEY UNDER

Application No. 69183 Permit No. 50170
IN NAME OF

MICHAEL B. BANKS AND MARIANNE ALDERSON

Surveyed April 29, 1994, by J. Miller

app# S-85433
Permit# S-53977