


Twp. 39 S. R. 8 W.
of W. M. Oregon

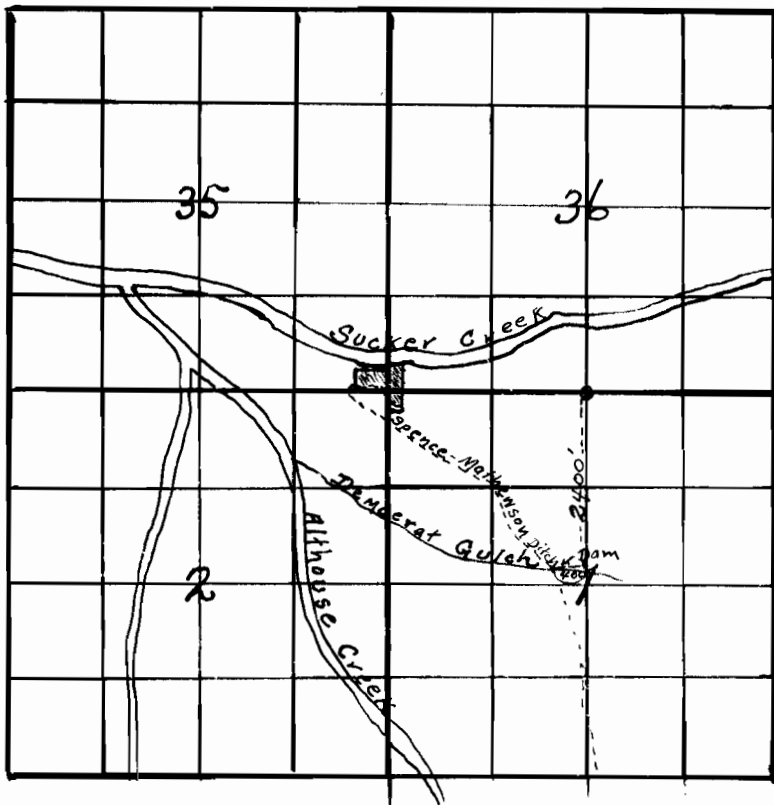

Twp. 40 S. R. 8 W.
of W. M. Oregon

A-8317
P-5400