FOR ASSESSMENT AND TAXATION ONLY

NW/4 NE/4 SECTION 26 T.19S. R.12W. W.M.
LANE COUNTY
SCALE 1" = 200'

DATE	REVISION	EMPLOYEE
11/12/02	CORR. BDY. T.L.'S 500, 700, 800, 801 & 1301	LCAT479
11/12/02	CANC 1400 & PTN 1500 INTO 1300	LCAT479

19 12 26 12
DUNES CITY
NAD 83/91

BASIN 18-MID
LANE COUNTY

SEE MAP 19 12 23

app # S-85527
Permit # 54036

WORKING COPY

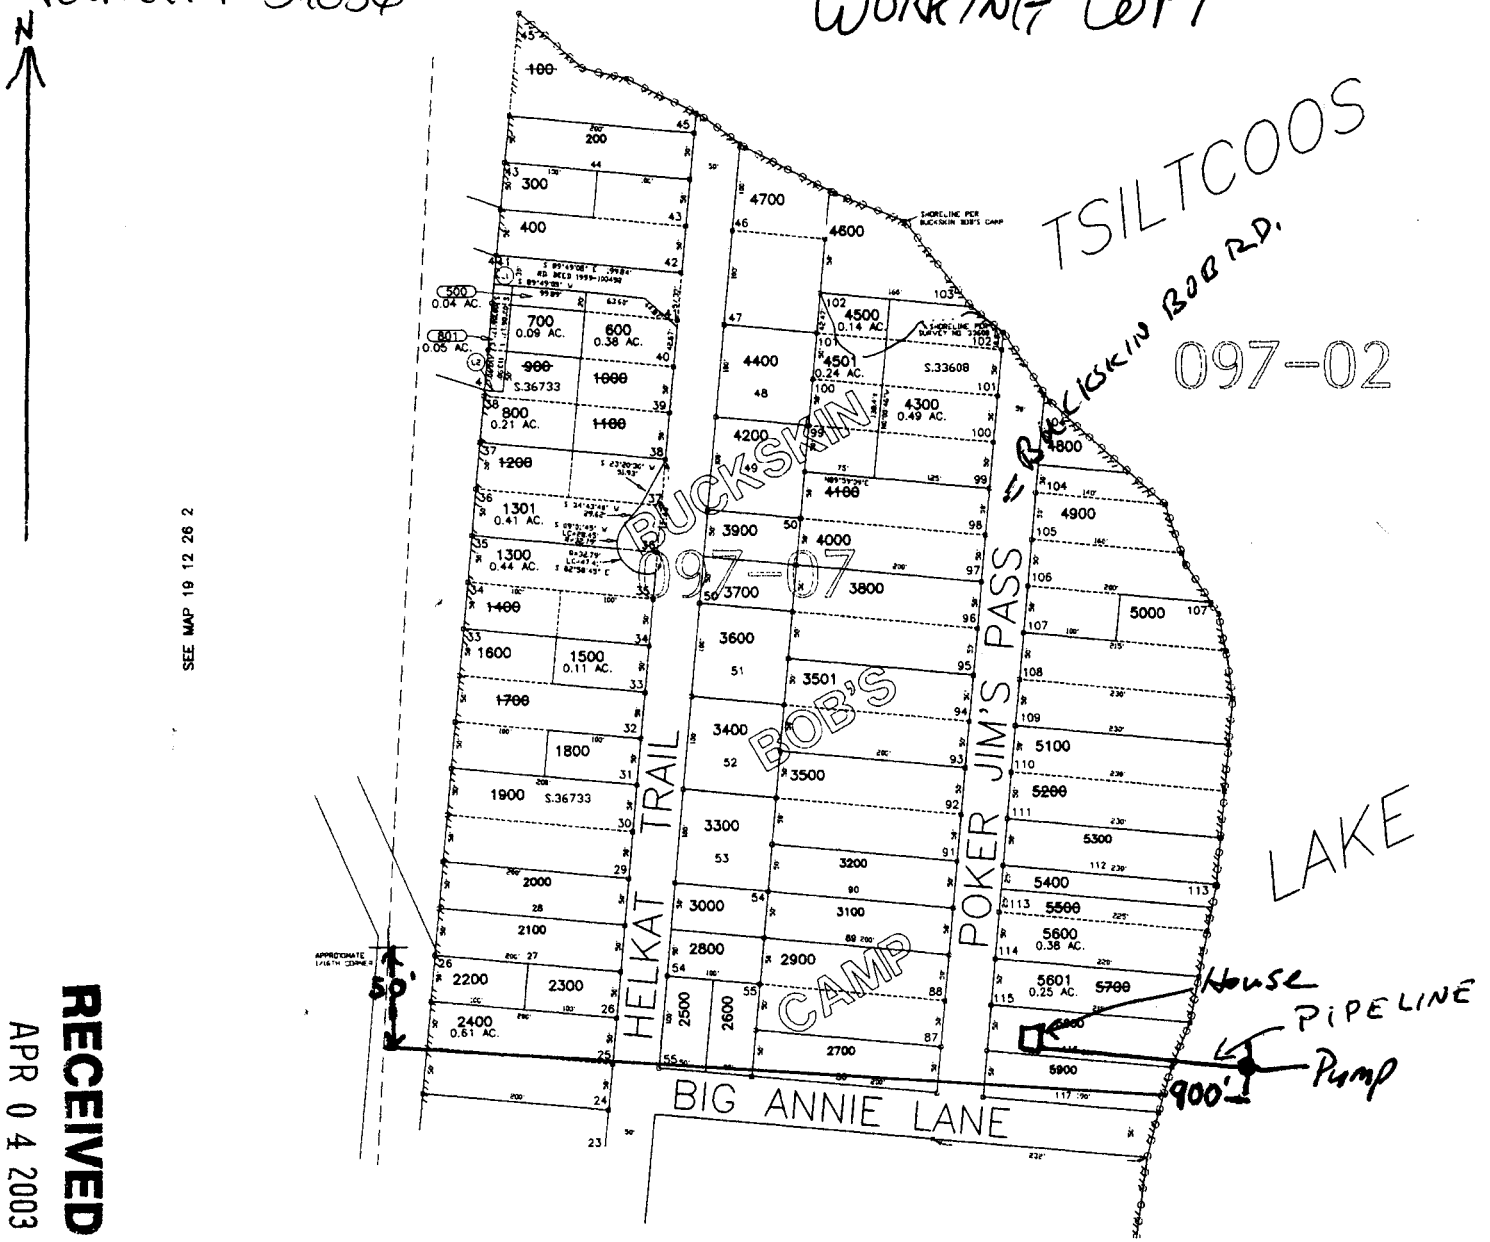

CANCELLED
100
1000
1100
1200
1400
1700
4100
5200
5500
5700
900

LINE TABLE

RECEIVED
APR 04 2003
WATER RESOURCES DEPT.
SALEM, OREGON