



WORKING COPY


Legend
 ■ = HOUSE
 ● = Intake/Pump

SE 1/4 Sec. 23 T.19S. R.12W.W.M.
 LANE COUNTY

19 12 23 4

1" = 400'

See Map 19 12 23 1

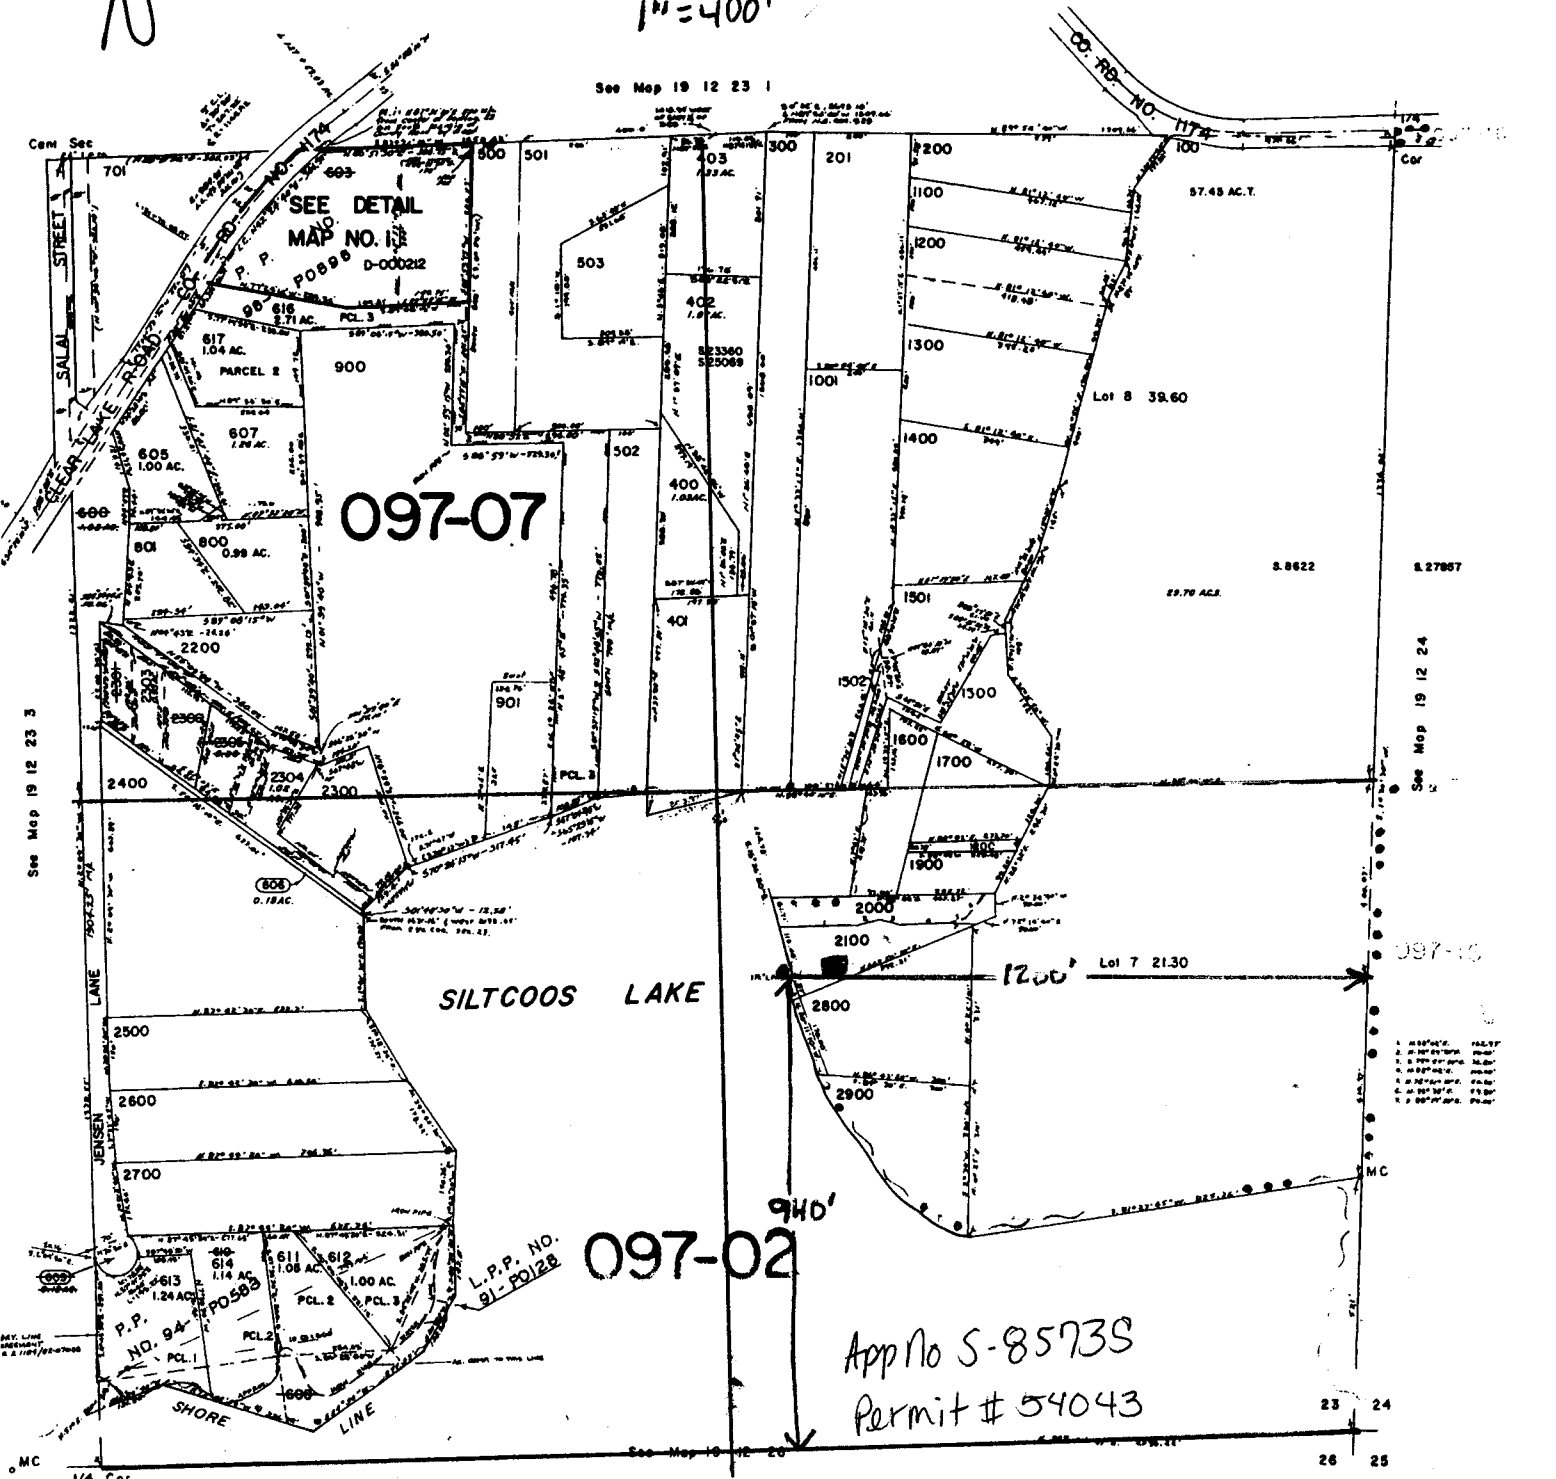

097-07

097-02

App No S-8573S
 Permit # 54043

23 24
 26 25