


Scale: 1" = 250'

Laboli/Carroll

Lot 403

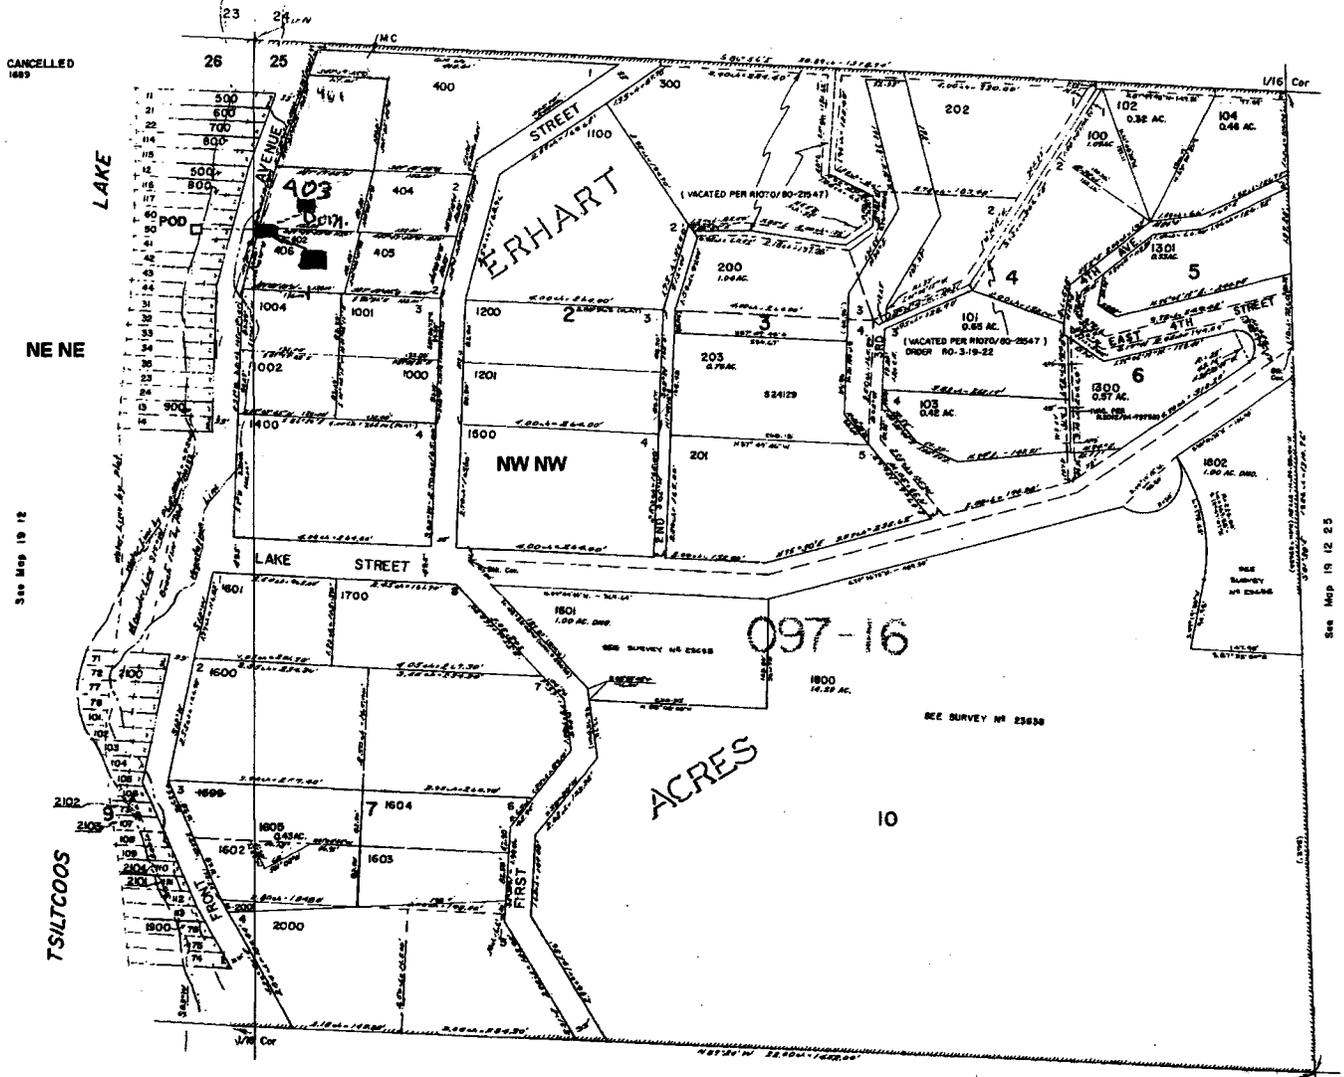

POD is located 250 ft. S. and 75 ft. W. from NW corner of Sec. 25

Legal is 19 12 25 22 00403

appno 8-85856
Permit # 54049

RECEIVED

JUN 23 2003

WATER RESOURCES DEPT.
SALEM, OREGON

RECEIVED

OCT 22 2003

WATER RESOURCES DEPT.
SALEM, OREGON