NW1/4 NW1/4 Sec. 25T.19S. R12 W.W.M.

LANE COUNTY

19 12 25 2 2

Laloli/Carroll Lot 403

Scale: 1" = 250'

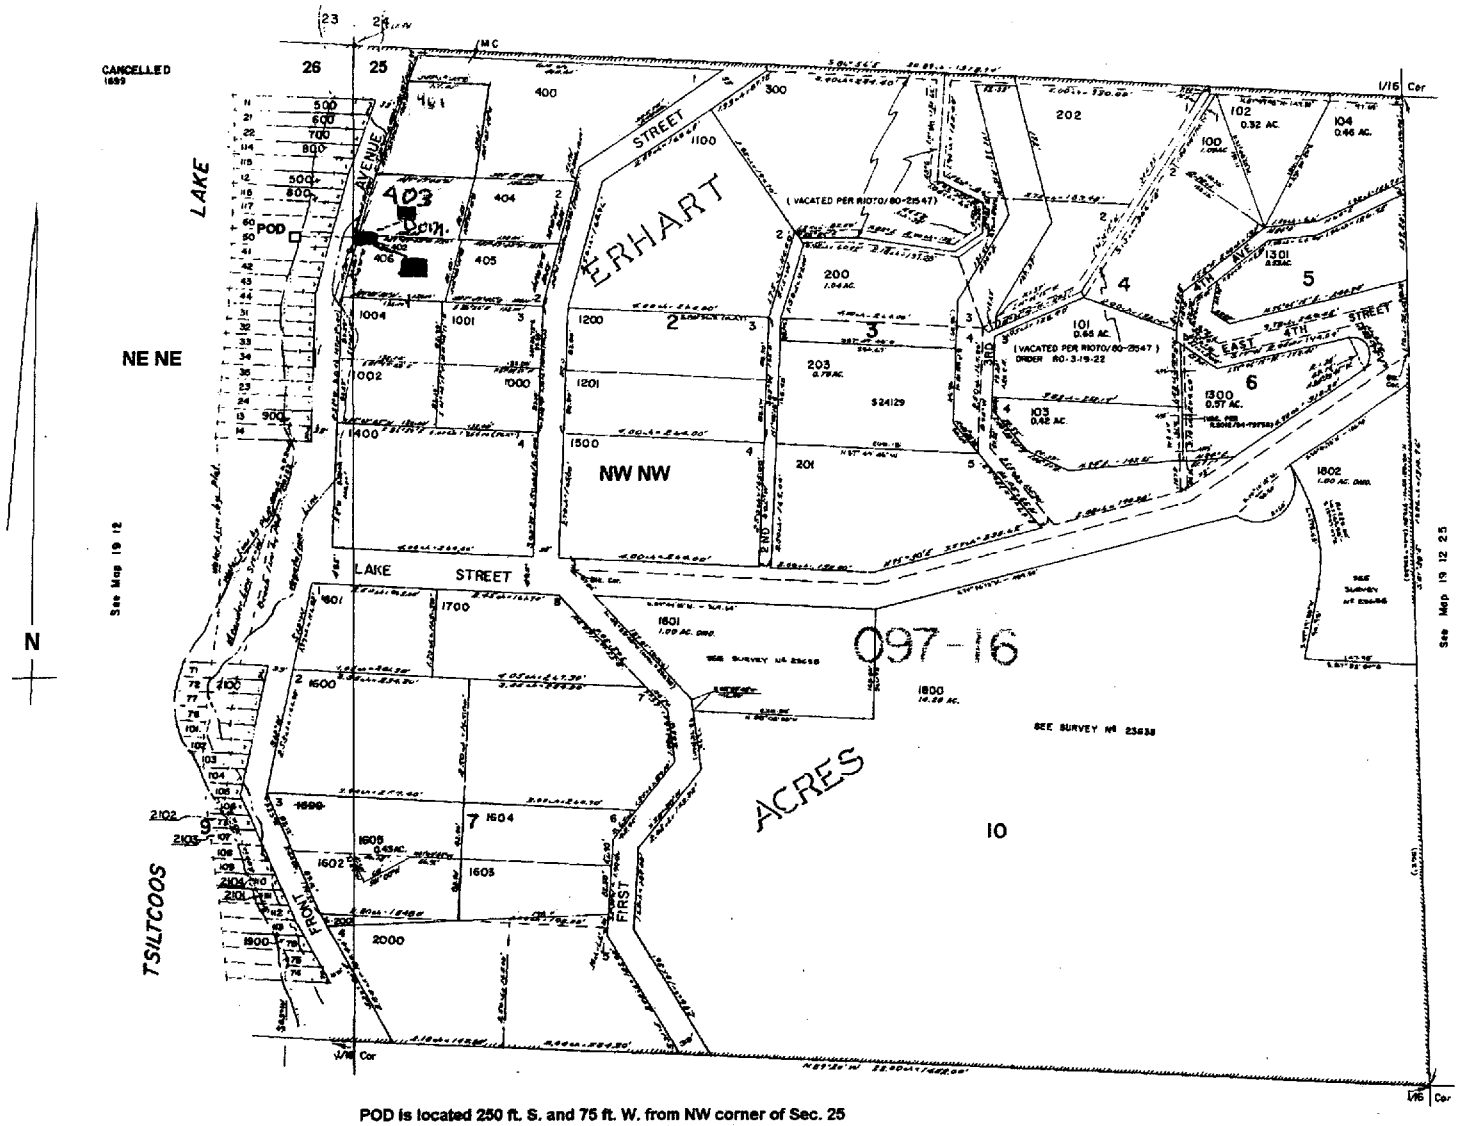

POD is located 250 ft. S. and 75 ft. W. from NW corner of Sec. 25

Legal is 19 12 25 22 00403

RECEIVED
JUN 23 2003
WATER RESOURCES DEPT.
SALEM, OREGON

appno. 85856
Permit # 54049

RECEIVED
OCT 22 2003
WATER RESOURCES DEPT
SALEM, OREGON