ADJUSTED ACCURATE SCALE

WORKING MAP

COMPILED FROM INFORMATION PROVIDED BY APPLICANT

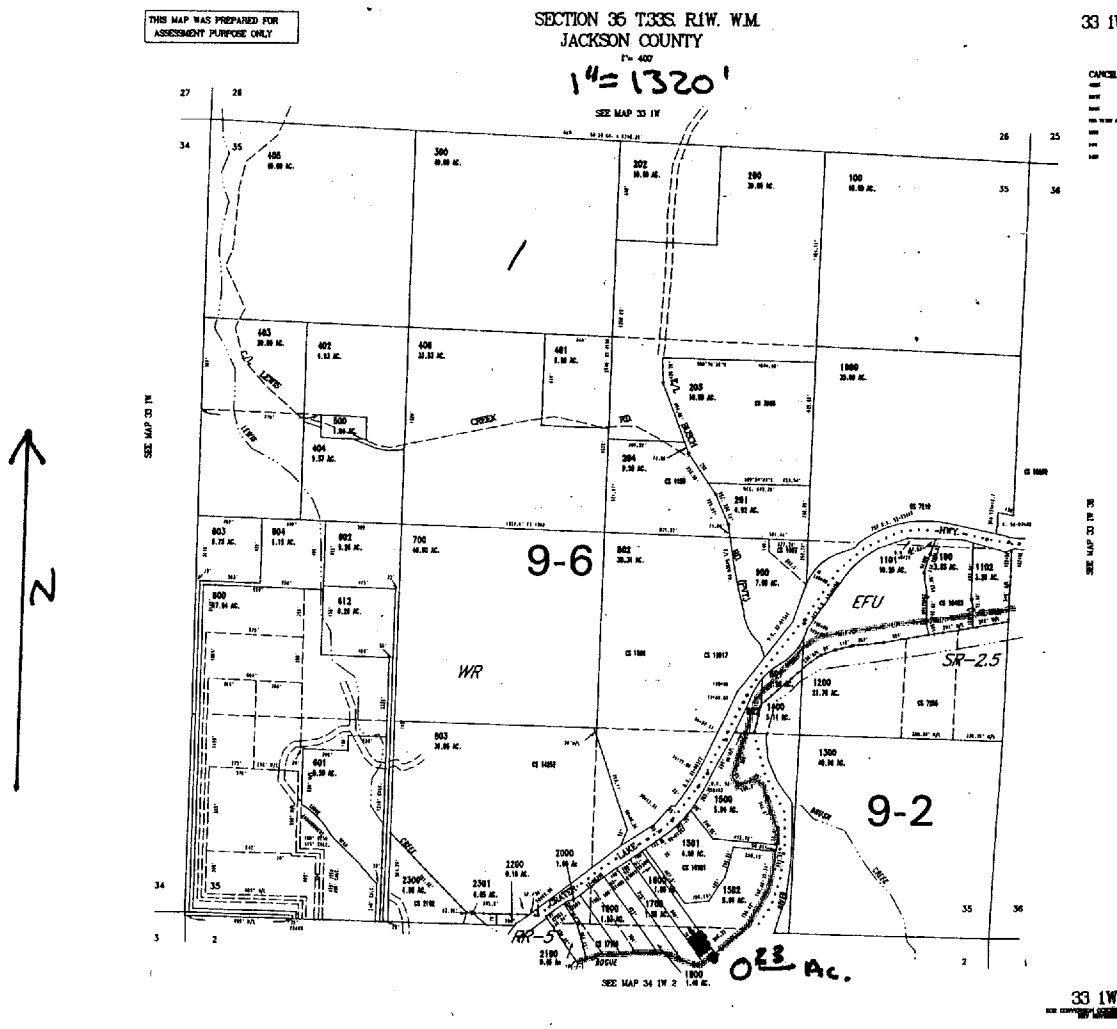

MSTAPILE C:/WORKSPACE/201H25 PLATCIRA
CREATED FRIDAY MARCH 29, 2002 1:02 AM By KIMYS

POD = 245' S & 820' E FM THE N ¼ COR SEC 2, T34S, R1W

POU = NWNE SEC 2 T34S, R1W

app no 3-85852
Permit no. 54090