


APPLICATION MAP
in the name of
JENKS-OLSEN FARMS, INC.

T 9 S, R 4 W, W.M.
sections 29, 31, 32

Work
copy

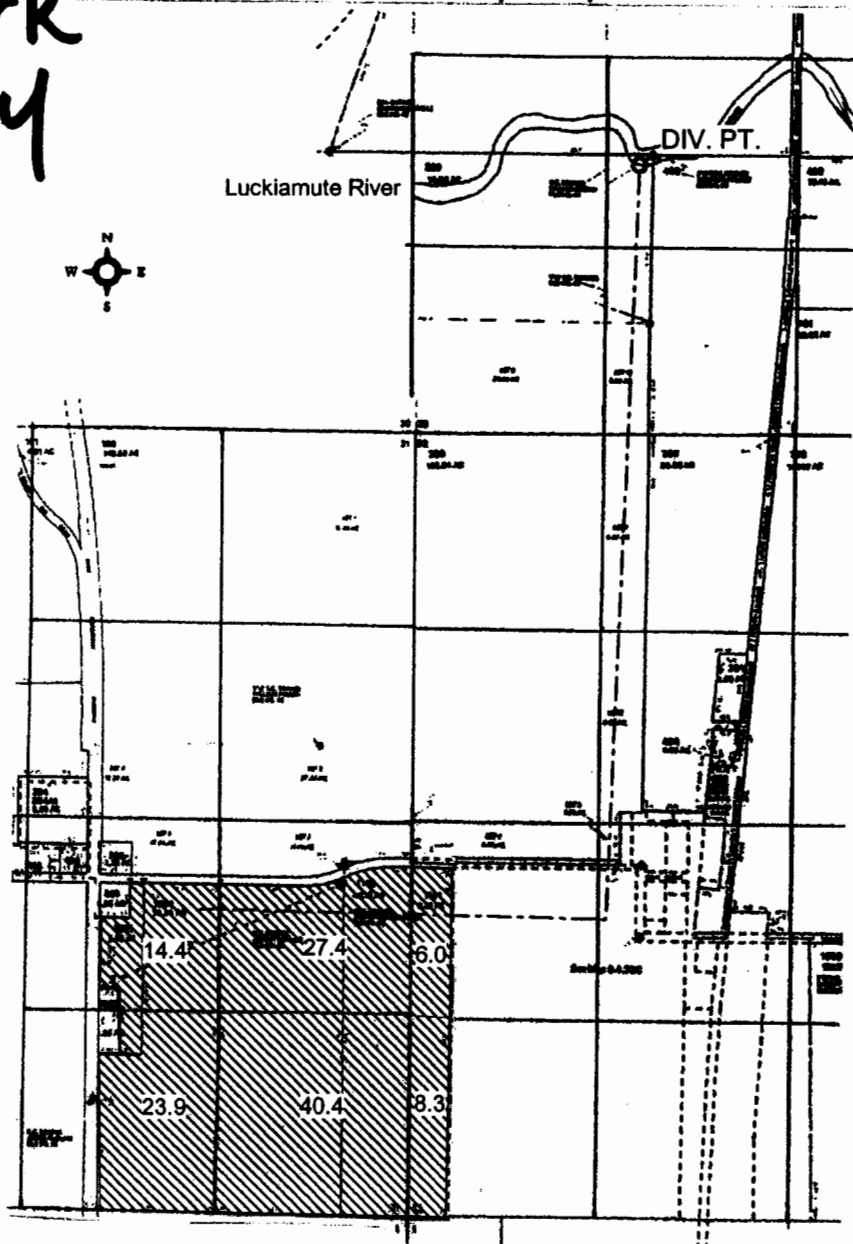

DIV. PT.: 1000' N & 100' W of the N'y SE Corner DLC ~~46~~
46

RECEIVED
JAN 27 2004
WATER RESOURCES DEPT
Salem, OR

4" = 1 mile



n Knauer Consulting
P.O. Box 5416
Salem, OR 97304

app no. S-85920
permit no. 54121