


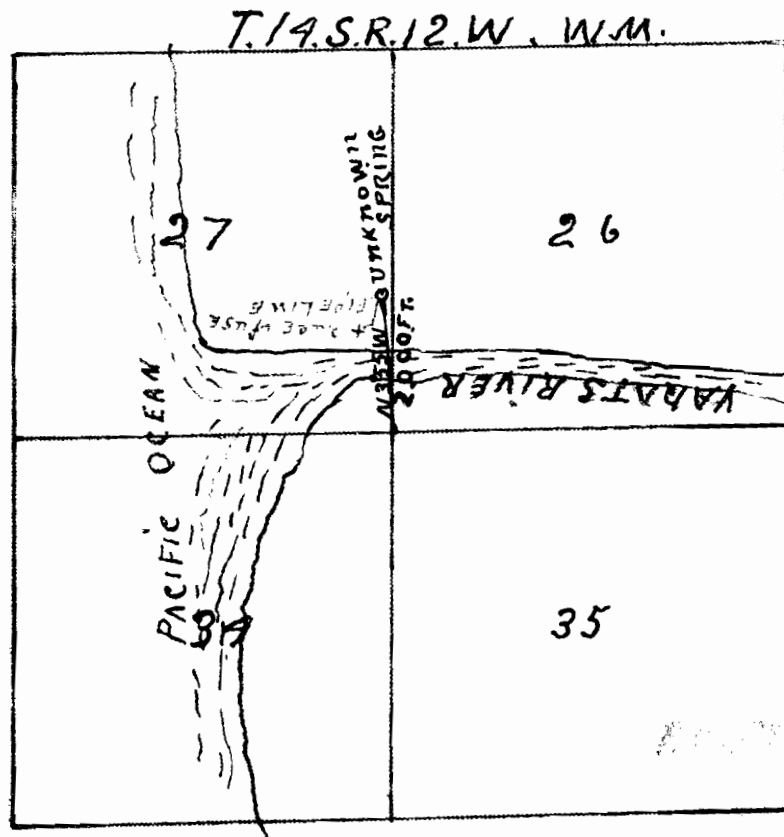

I Z M DERRICK OF TOLEDO DO HEREBY
 CERTIFY THAT THIS MAP WAS MADE FROM
 NOTES TAKEN DURING AN ACTUAL SURVEY
 MADE BY ME ON AUGUST, 12, 1921.
 AND THAT IT CORRECTLY REPRESENTS THE
 WORKS DESCRIBED IN THE ACCOMPANYING
 APPLICATION TOGETHER WITH THE
 LOCATION OF STREAMS AND OTHER
 DITCHES IN THAT IMMEDIATE VICINITY

Z M DERRICK
 REGISTERED PROFESSIONAL ENGINEER

OR 910

DEC 31 1919
 DATE OF REGISTRATION

83136

5414

- SCL-217-MI-