


appno 5-85815

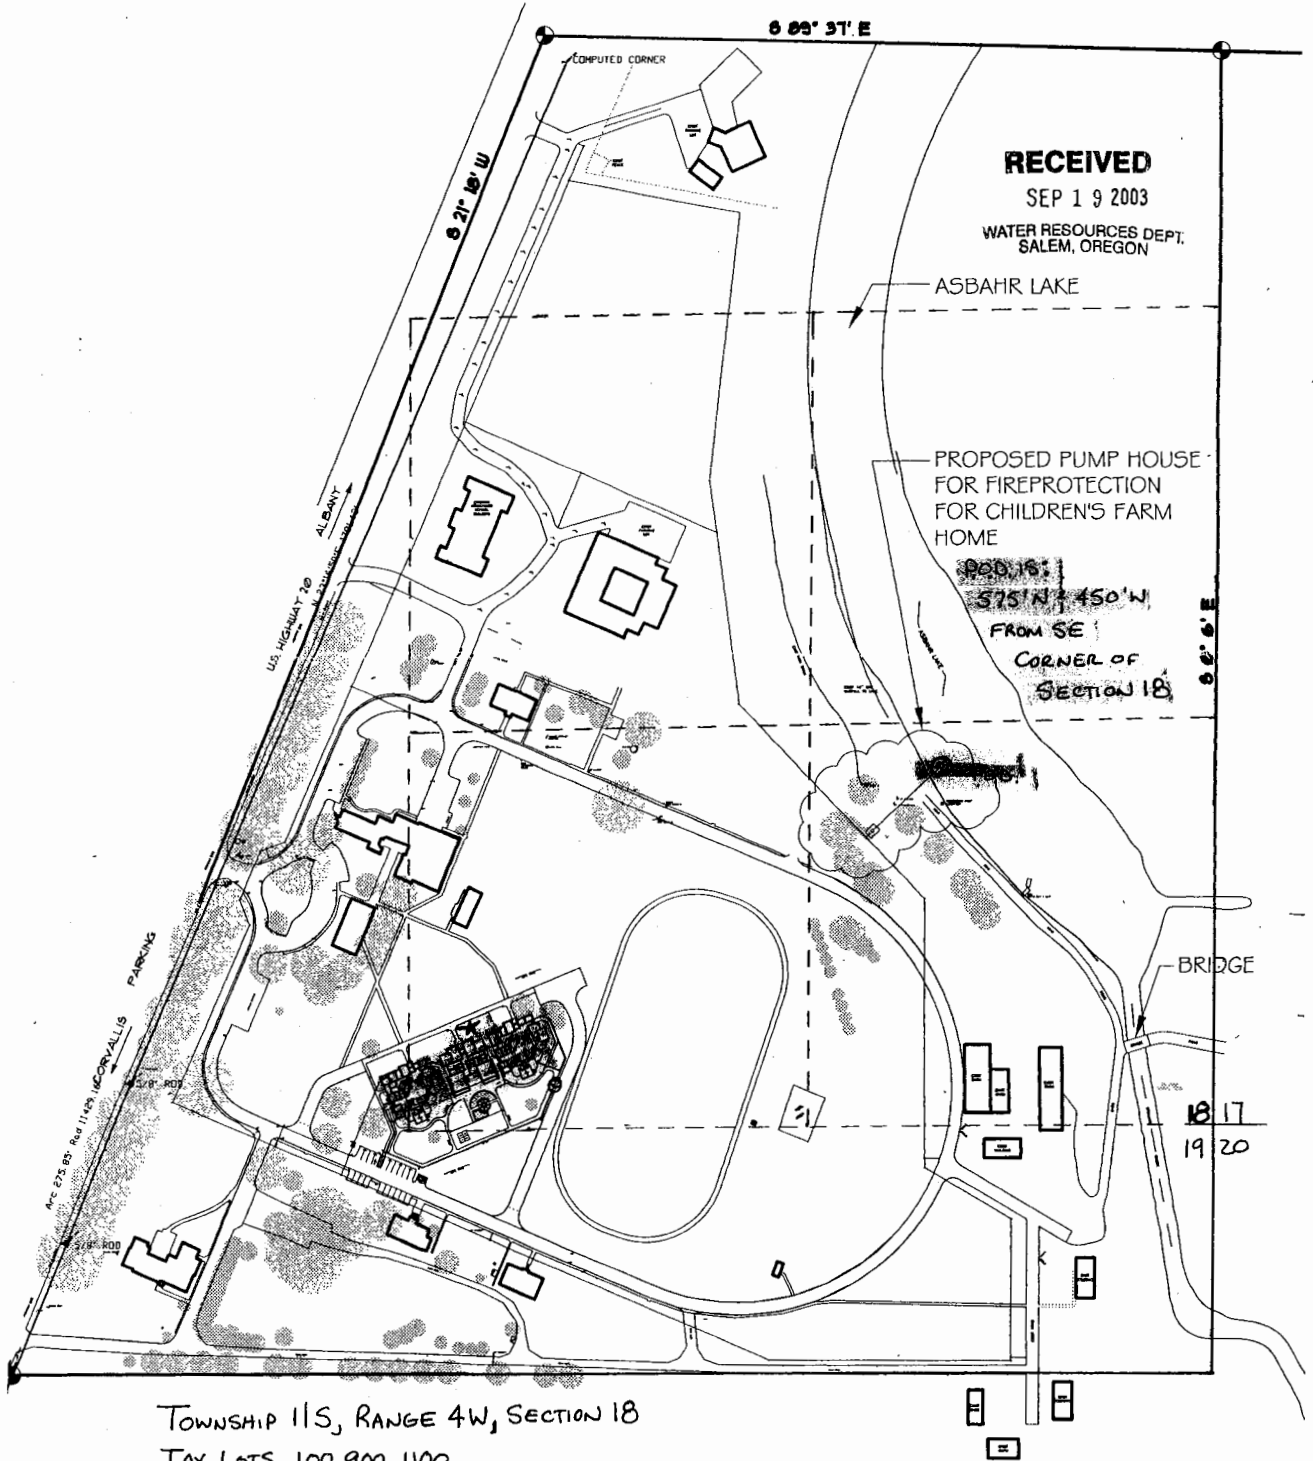

TOWNSHIP 11S, RANGE 4W, SECTION 18
 TAX LOTS 100, 900, 1100

★ TO SERVE HIGHLIGHTED BUILDINGS.

SITE PLAN CHILDREN'S FARM HOME

SCALE: 1" = 200'-0"

