

# FISHER SURFACE WATER PERMIT APPLICATION

TAX LOT: 2301

LEGAL: SW 1/4, SE 1/4, SEC 10  
T 7 S, R 38 E

COORDINATES: N 44 57.877  
W 118 02.607

NAME: "CISTERNA" SPRING

LOCATION: 534' N OF SE CNR SEC 10  
.43 MI W OF SE CNR SEC 10

PLACE OF USE: Z.A.C. M.O.L.

"CISTERNA" SPRING


RESIDENCE FOR DOMESTIC USE  
(AT #48146 FOOTHILL RD.)

RECEIVED

MAR 23 2004

WATER RESOURCES DEPT  
SALEM, OREGON

SCALE  
1" = 400'

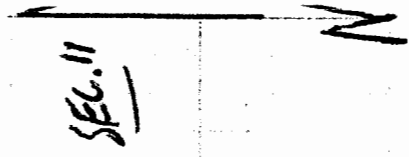

Sec. 10

STOCKWATER TROUGH  
(STOCK + WILD LIFE USE)  
534' N OF SE CNR SEC 10  
2230' W OF SE CNR SEC 10

FOOTHILL ROAD

400' N OF SE CNR  
2000' W OF SEC NR 10

2280' W OF  
0.432 MI W OF

SEC NR SEC 10

T 534' N OF SEC 10  
SE CNR SEC 10

SEC NR

SEC 10

