APPLICATION MAP
In the name of
PAUL MULKEY LIVING TRUST

FEB 5 2004

T 9 S R 4 W, W.M.
Sections 29, 32

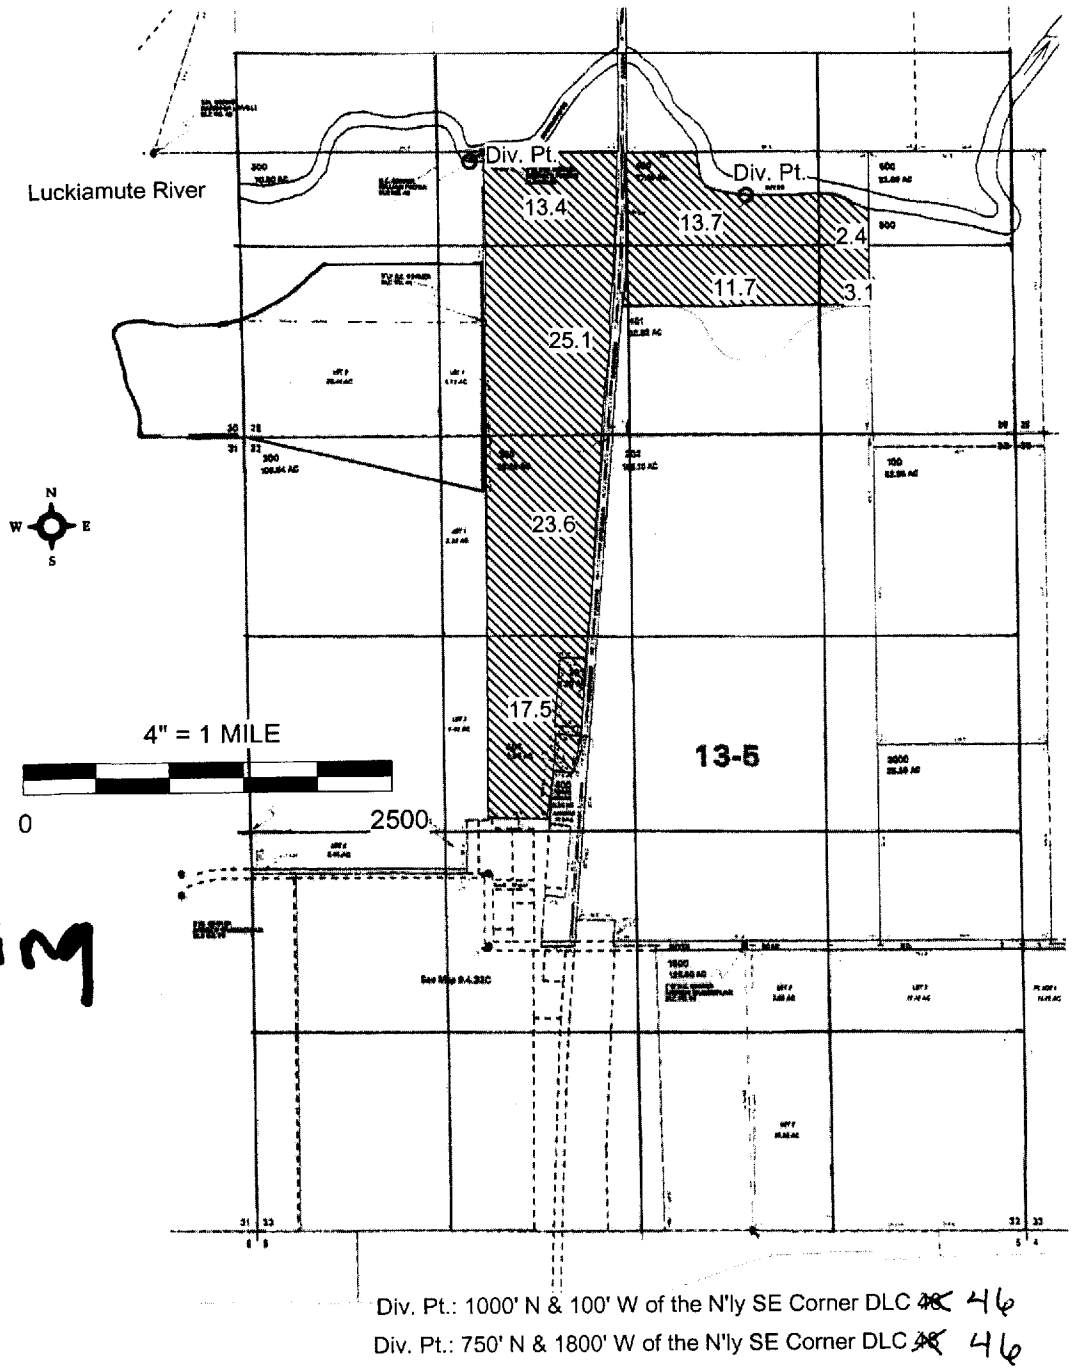

Working Copy

Div. Pt.: 1000' N & 100' W of the N'ly SE Corner DLC ~~46~~ 46

Div. Pt.: 750' N & 1800' W of the N'ly SE Corner DLC ~~46~~ 46

Don Knauer Consulting
P.O. Box 5416
Salem, OR 97304

Permit # 54153

App. No. S-85935