

Northwest 1/4 Section 19, corner

RECEIVED

JUL 16 2004


WATER RESOURCES DEPT  
SALEM, OREGON

Section 19 SW 1/4

Center  
Section 19  
&  
NE 1/4 section corner

Location  
MAP FOR WATER Right Application Located in  
Section 19 Township 29 South, Range 11 West W. 1  
COOS County, OREGON  
TAX LOT 400

FOR  
HAL AND Patti Strain  
P.O. Bx 312  
Myrtle Point, OR 97458

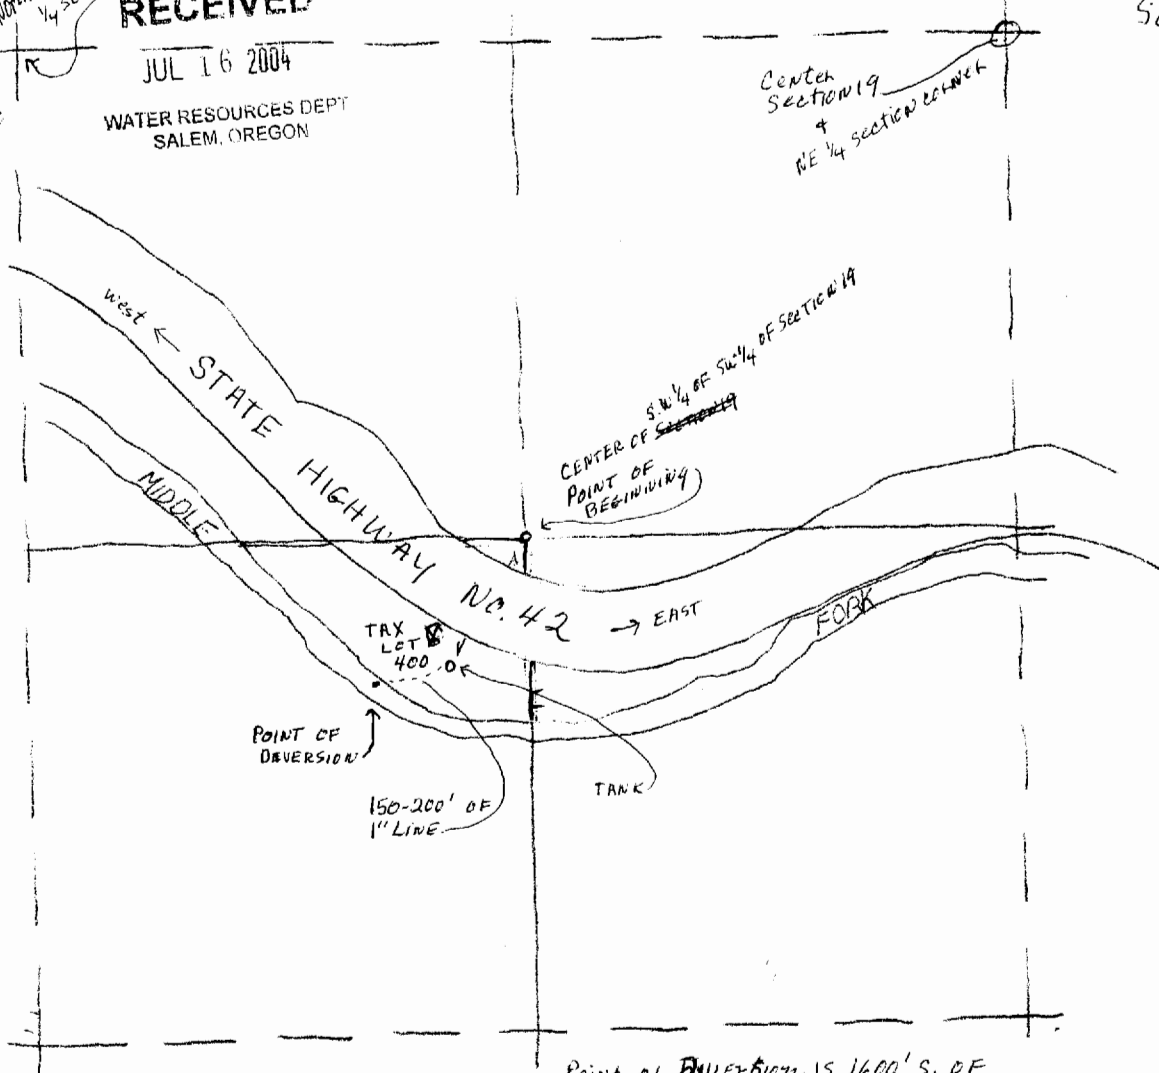

Date  
July 14, 2004

North ↑  
One inch = 400 feet

RECEIVED  
JUL 26 2004  
WATER RESOURCES DEPT  
SALEM, OREGON

This map is for the purpose of identifying the location of the water right only & is not intended to provide legal dimensions or locations of property ownership lines.

⊗ Location of house

app no. 586060

NOTE: THE P.O.D. and water line/TANK IS

Point of Diversion is 1600' S. OF  
Center of Section 19 and 1600' W.  
OR 300' S. OF POINT OF BEGINNING at  
Center of SW 1/4 of Section 19 and 400' W.