


Application of F.F. Roberts, Cove, Oregon.

8348

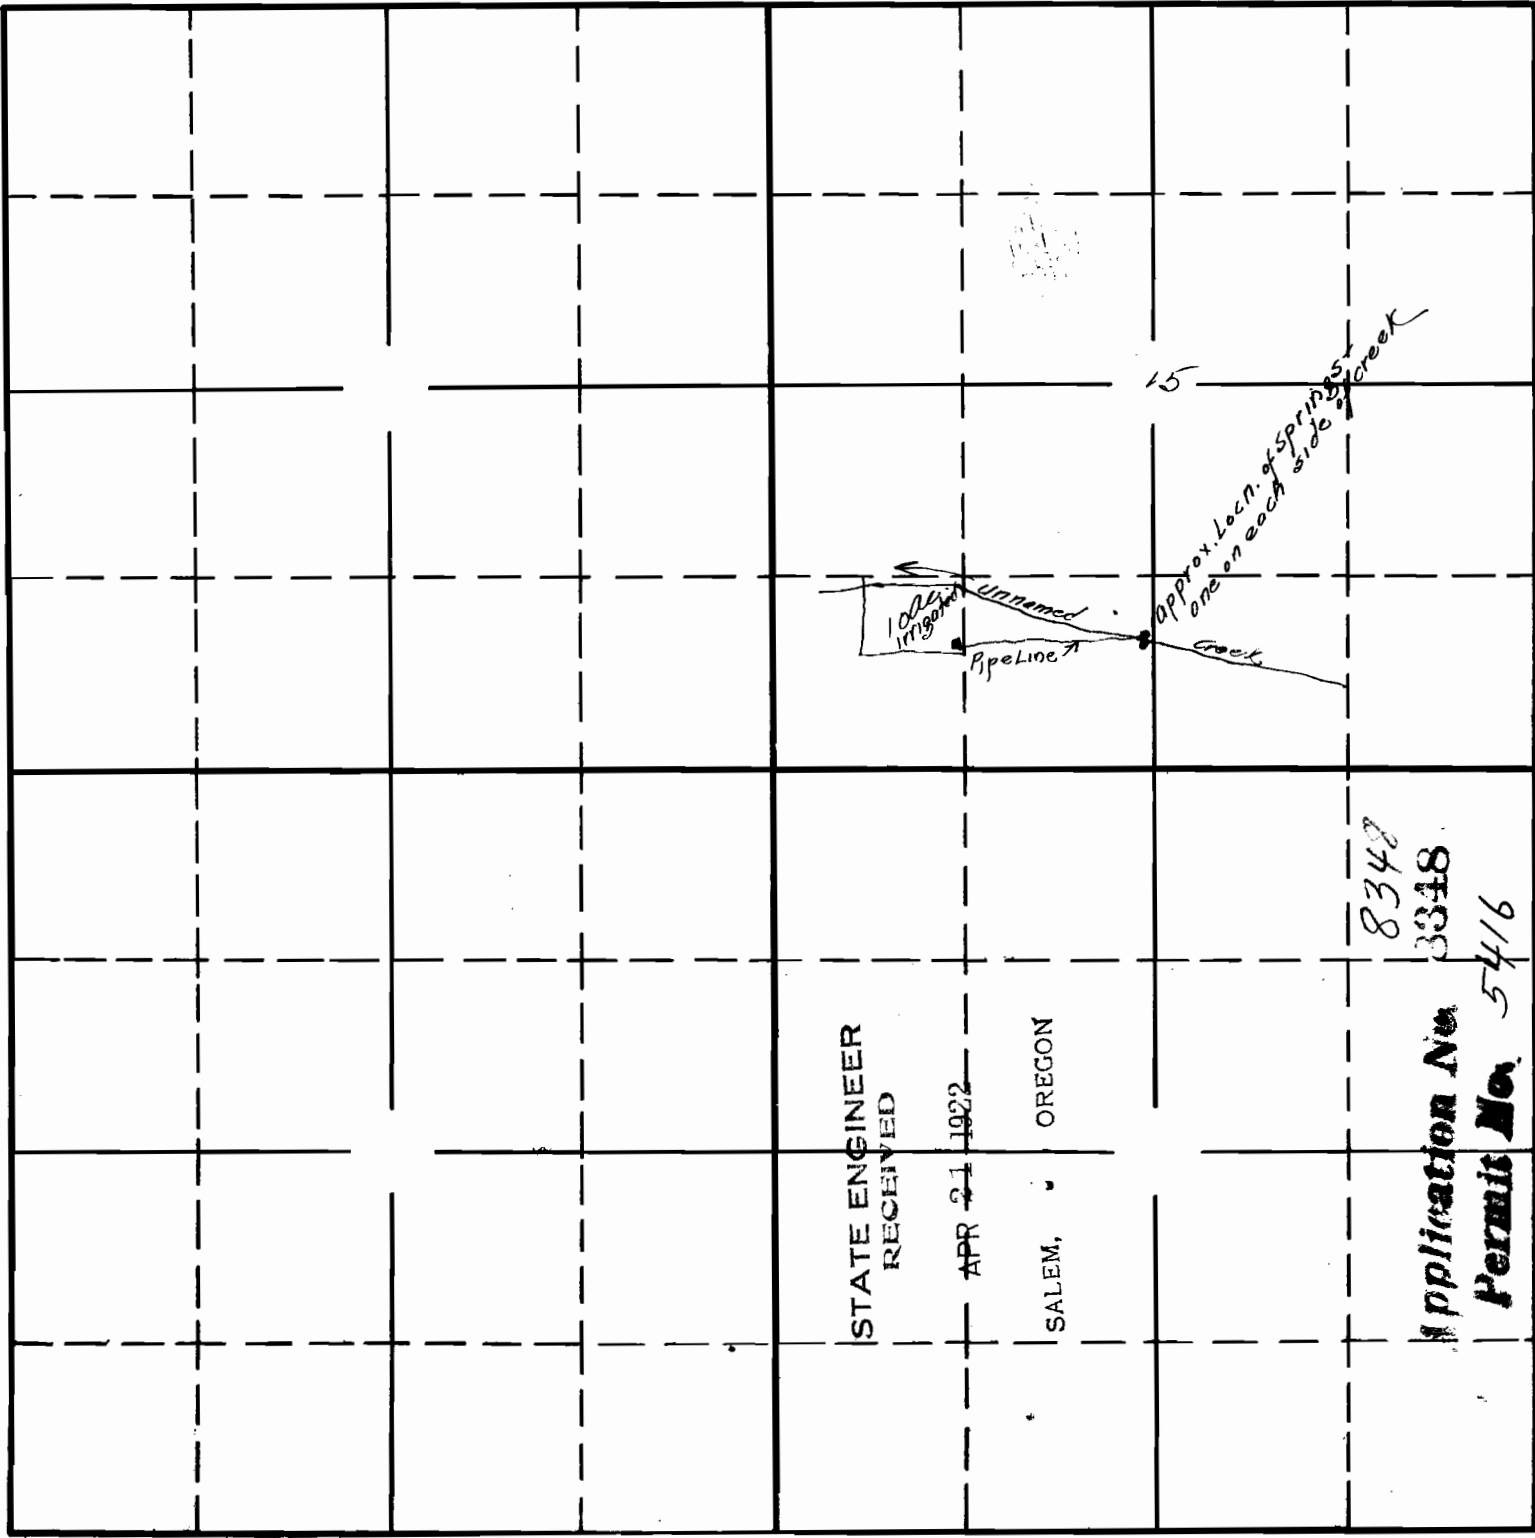

STATE ENGINEER
RECEIVED

APR 21 1922

SALEM, OREGON

Application No. 8348

Permit No. 5416

Sec. 15
Tp. 35
R. 406