

W.W.M.

MAY 03 2004 37 6 17


NTY RECEIVED

SCALE 1" = 400'

WATER RESOURCES DEPT  
SALEM, OREGON

MAY 13 2004

WATER RESOURCES DEPT  
SALEM, OREGON

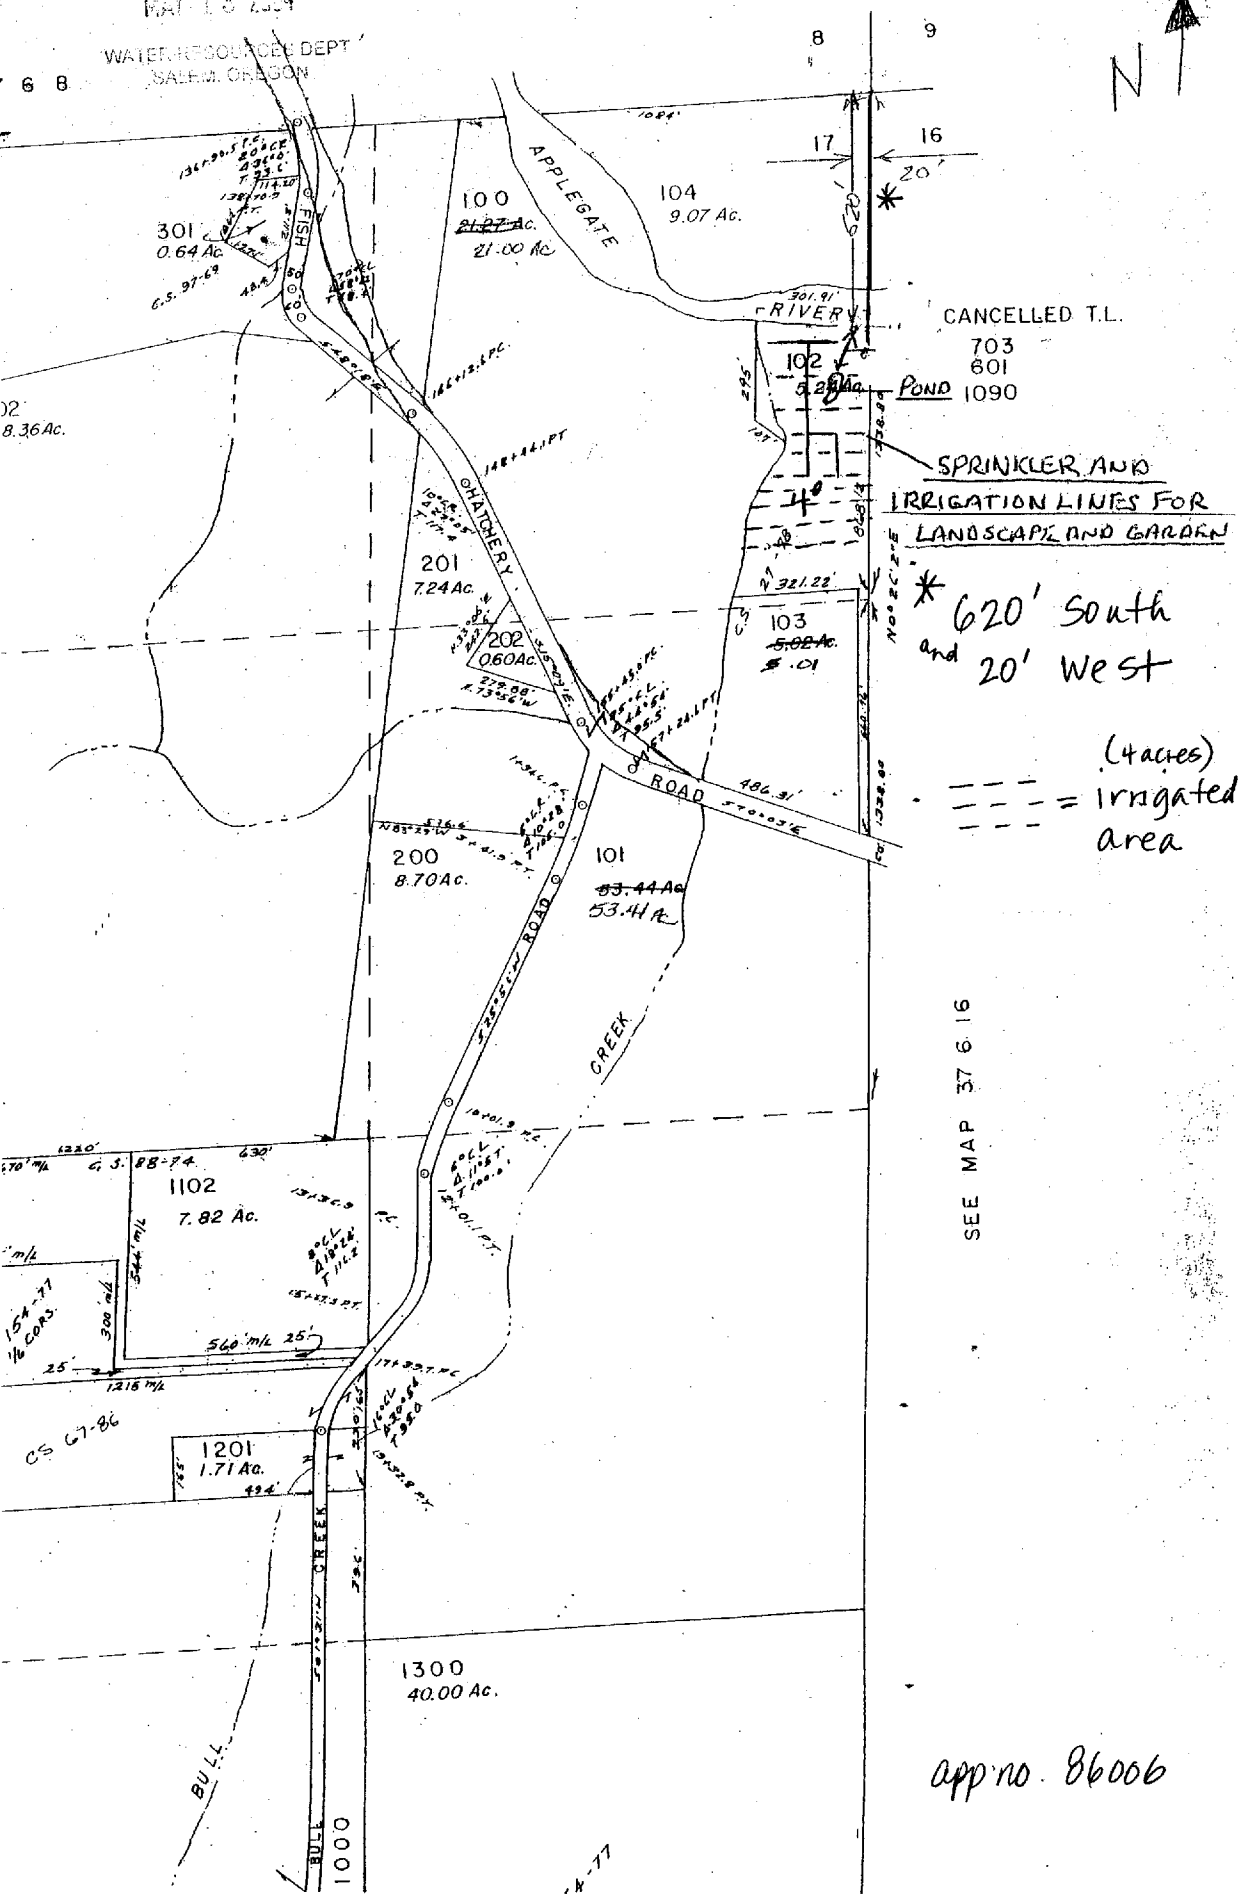

SEE MAP 37 6 16

app no. 86006