


CURRY COUNTY

1" = 200'

SEE MAP 41 12

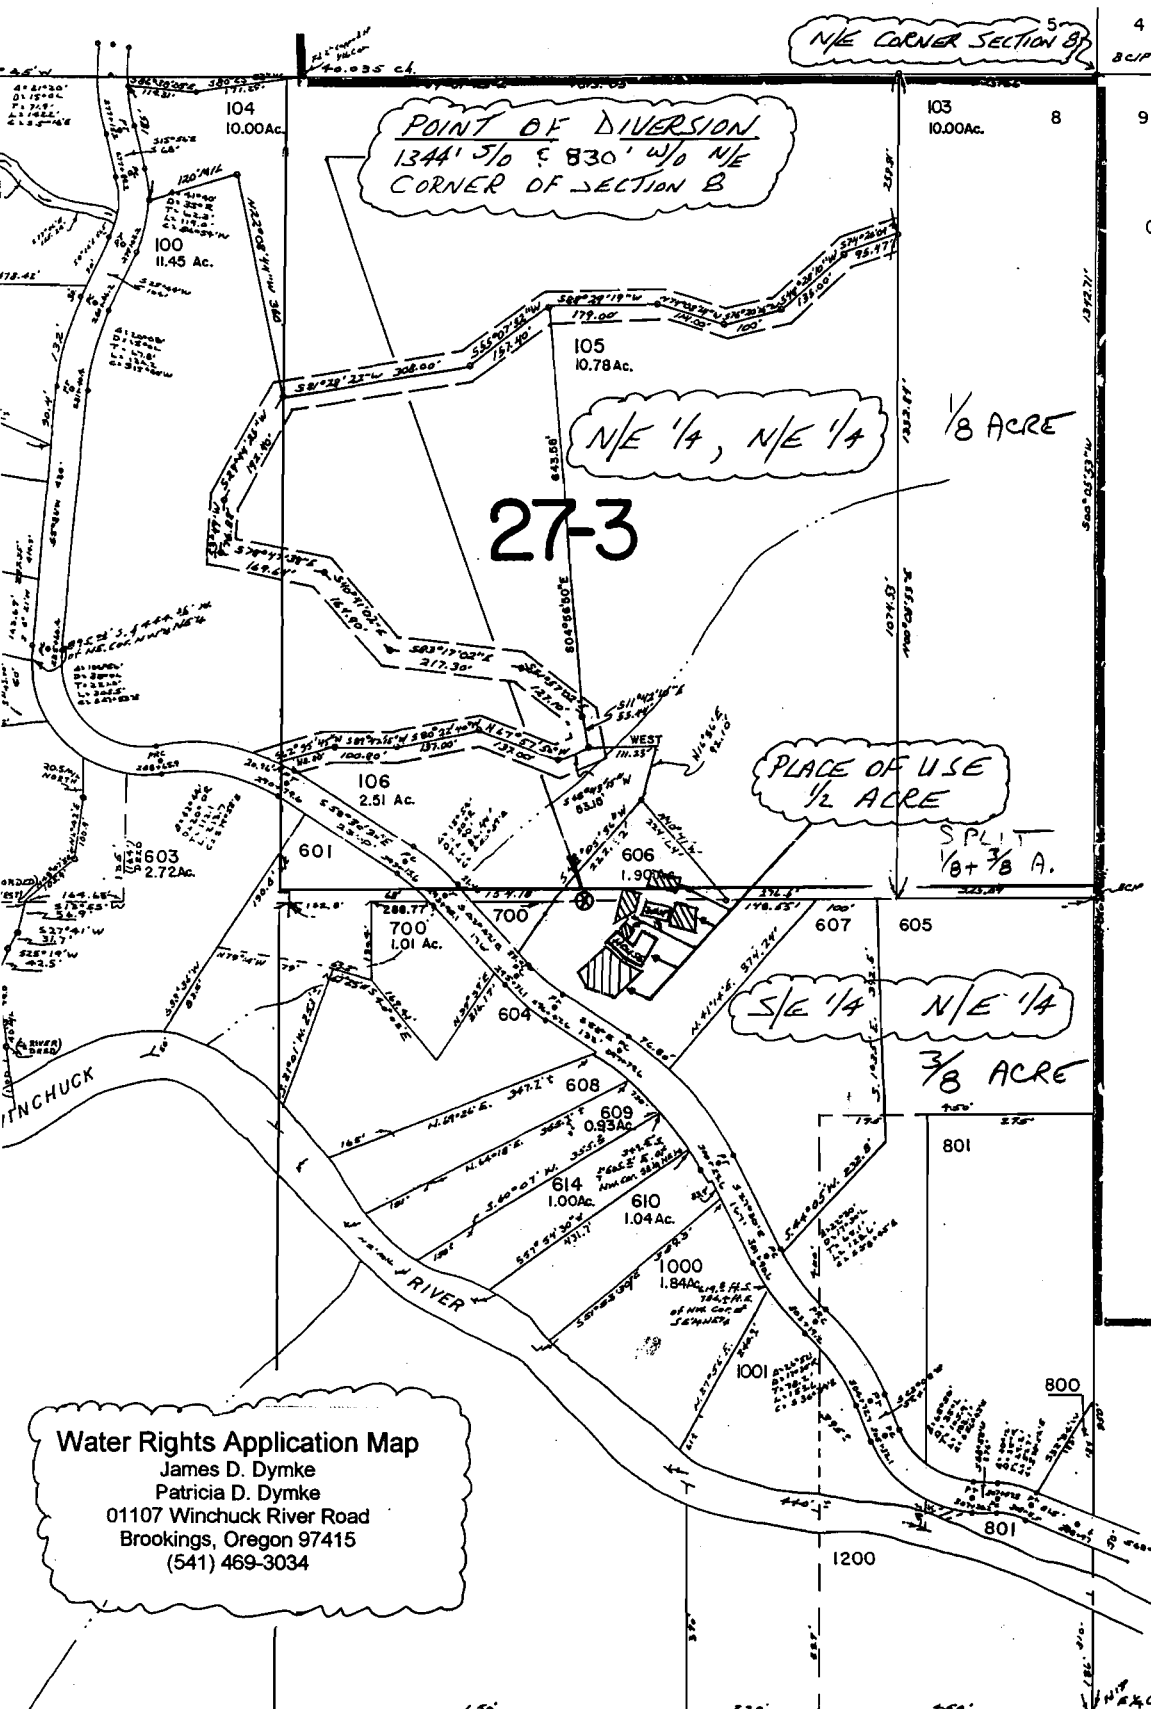

CANCELLED NO.

- 602
- 612
- 900
- 1100
- 401
- 1002
- 102
- 613
- 107



SEE MAP 41 12

Water Rights Application Map
 James D. Dymke
 Patricia D. Dymke
 01107 Winchuck River Road
 Brookings, Oregon 97415
 (541) 469-3034

app no. S86104

SEE MAP 41 12

RECEIVED

SEP 17 2004

WATER RESOURCES DEPT
SALEM, OREGON

RECEIVED

SEP 17 2003

WATER RESOURCES DEPT.
SALEM, OREGON