

17030210
Assessor SCRG

LEGEND
1" = 800 FEET

- LINE TYPES**
- OLD PROPERTY LINE
 - VIOLATED BOUND-UP-LINE
 - BOUND-UP-LINE
 - RAILROAD BOUND-UP-LINE
 - SPRINKLER LINE ETC.
 - UTILITY LINE ETC.
 - PLATTING PLAT BKT.
 - TAX CODE BOUNDARY
- SYMBOL TYPES**
- WELL
 - CONTROL POINT
 - SHRUBB INVENTORY
 - CLAS. CORNER
 - 1/4 SEC.
 - 1/2 SEC.
 - 3/4 SEC.

NUMBERS
THE CODE NO.
00000000

NOTE: THIS MAP WAS CREATED FOR ASSESSOR'S OFFICE USE ONLY.



SCALE 1" = 800 FEET
15000
Plot file created: December 01, 2003


- SE/NE 0.75 Ac
- NE/SE 20.5 Ac
- NW/SE 1.5 Ac
- SE/SE 0.65 Ac

TOTAL 23.40 ACRES
PRIMARY

RECEIVED
MAR 2 3 2005
WATER RESOURCES DEPT.
SALEM, OREGON

RECEIVED
MAR 2 3 2005
WATER RESOURCES DEPT.
SALEM, OREGON

app # R 86211

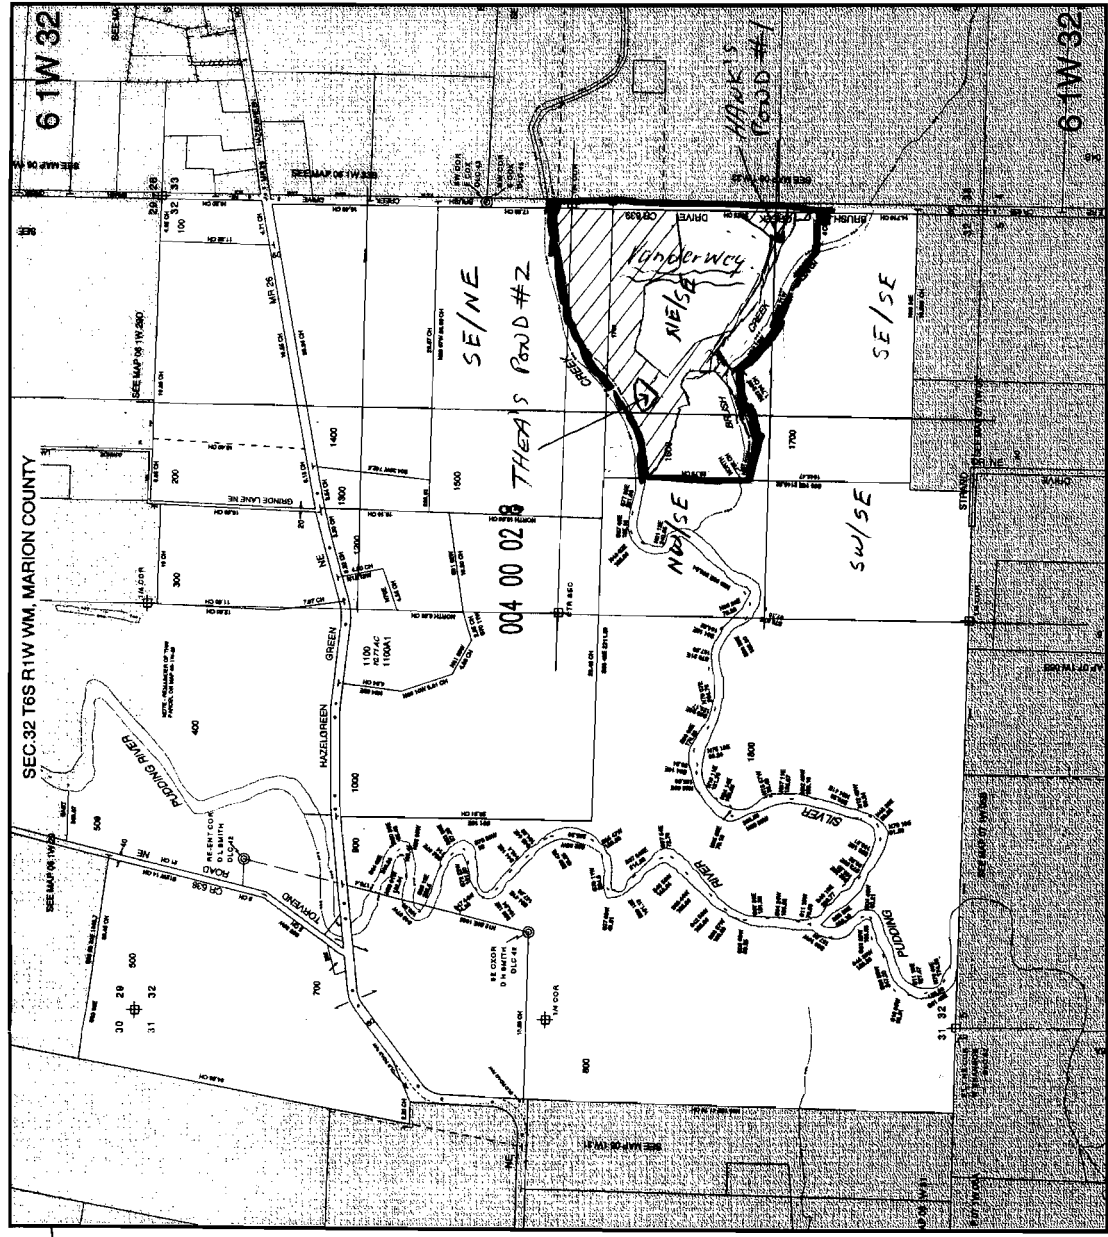

THEA'S POUD #2 NE 1/4 SE 1/4
LOCATED FROM SE CORNER
SECTION 32

2120 FE NORTH
1200 FE WEST

HARK'S POUD #1
POD MEASURED FROM
SE CORNER SECTION 32

1640 FE NORTH
1000 FE WEST