

FOR ASSESSMENT
AND TAXATION
ONLY


SECTION 31 T.16S. R.2E. W.M.
LANE COUNTY

SCALE 1" = 200' 1000'
SEE MAP 16 25

1100	1100	1100	1100

16 25 31

C.A.D. SYS.

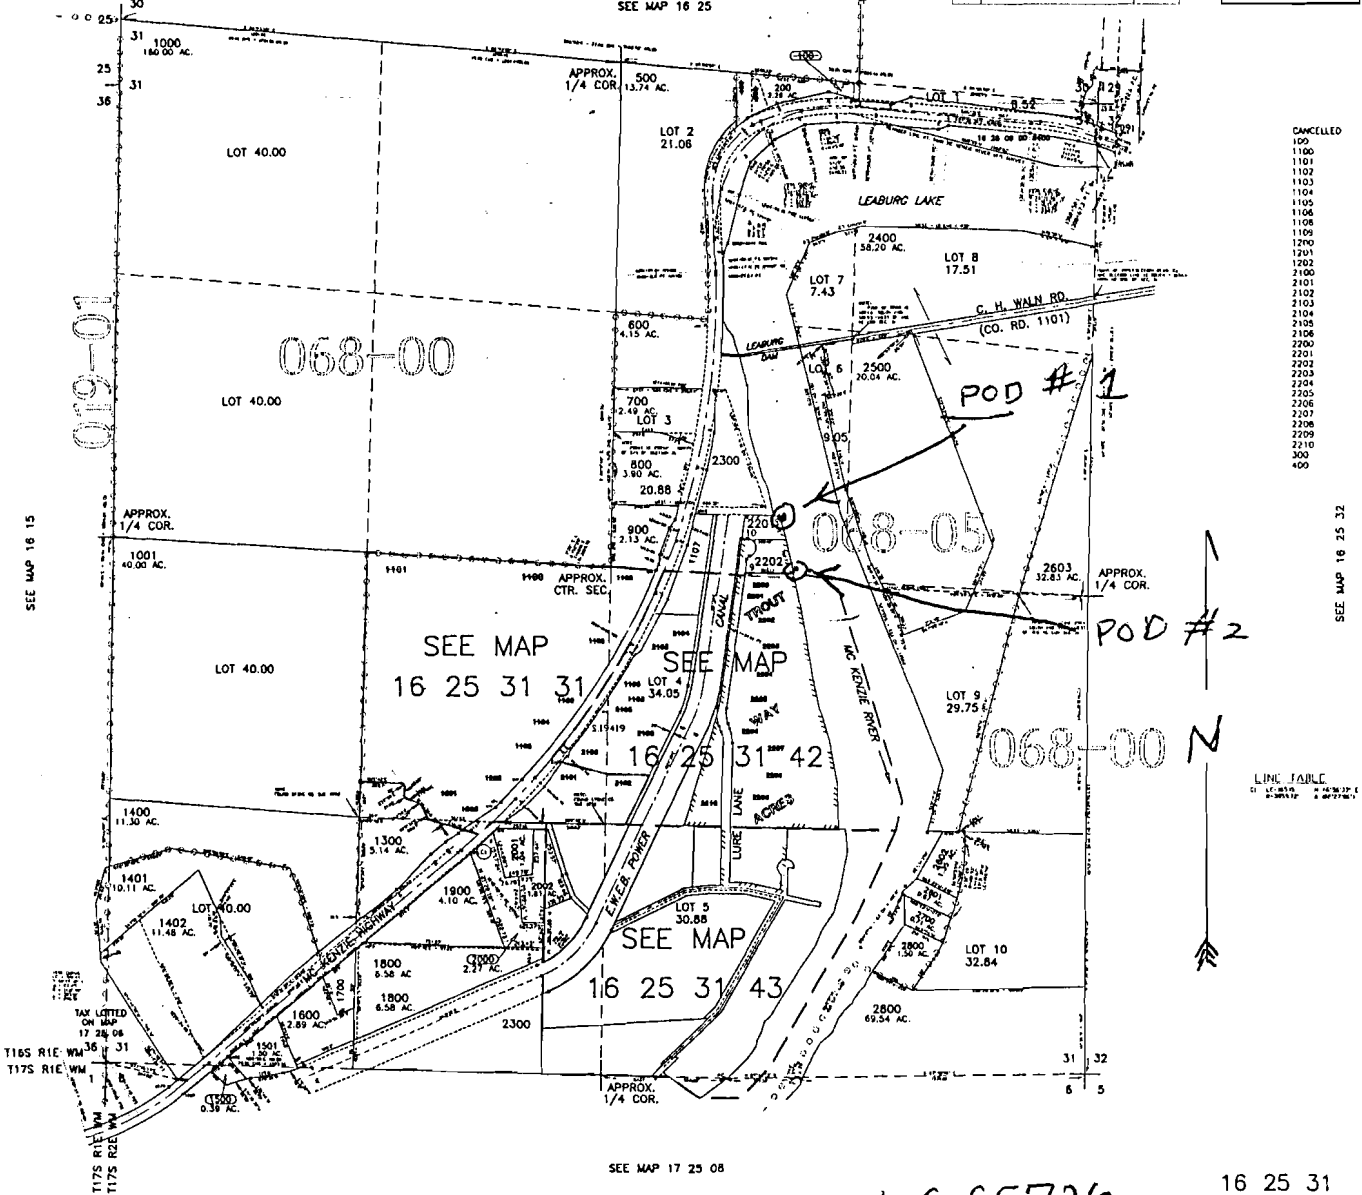

App No S-85726

