

THIS MAP WAS PREPARED FOR
ASSESSMENT PURPOSE ONLY

TAX LOT 100
SW 1/4 SEC. 25 T. 24 S. R. 11 W. W.M.
COOS COUNTY

WORK
COPY

24 11 25C
& INDEX

CANCELLED
601

SCALE: 1" = 400'

1/4 COR.

SEE MAP 24 11 25

SUBJECT
PROPERTY


100' 1" PIPE
TO POINT OF USE

POINT OF USE
DOMESTIC
100' W

POINT OF
DIVERSION ON
N 43° 27.56'
W 123° 57.06'

NE 1/4 SW 1/4

350' S
100' W
Ck 4
Sec 25

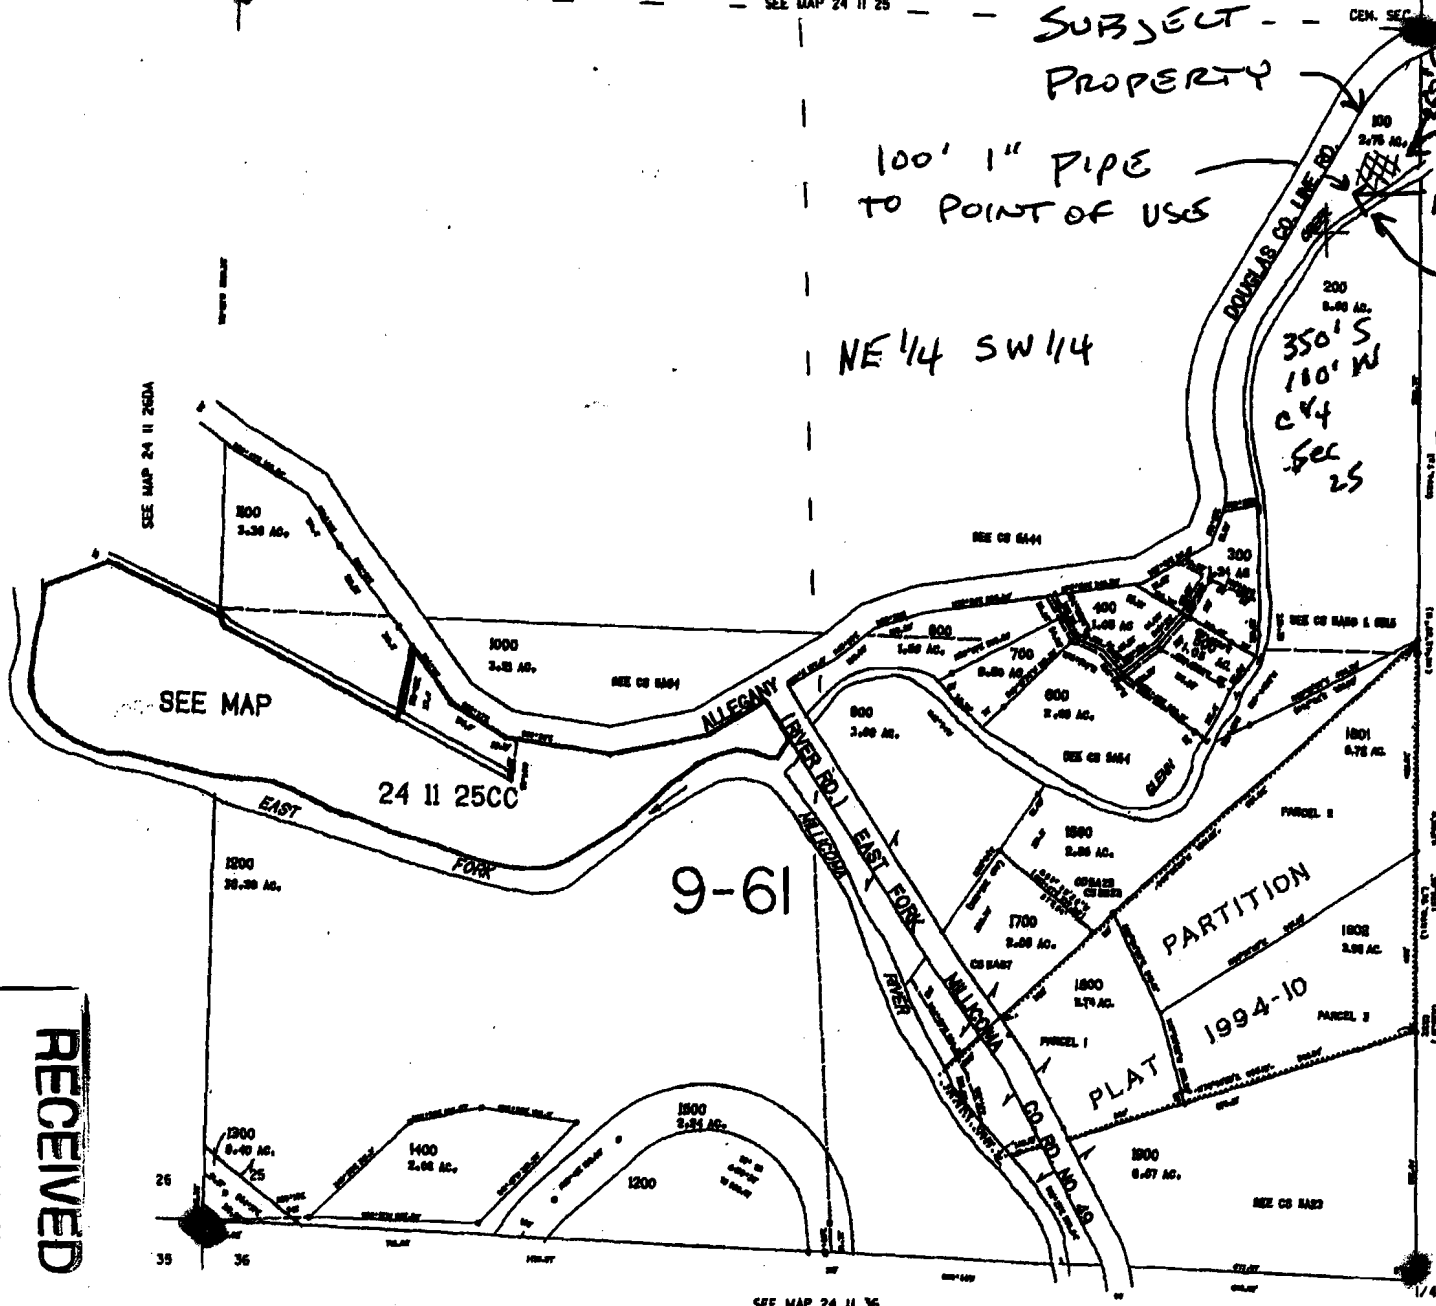

app # S86257

RECEIVED
APR 14 2005
WATER RESOURCES DEPT
SALEM, OREGON

SEE MAP 24 11 36

1/4 COR. 60426
24 11 25C
& INDEX