

ONLY


REVISED MAP 1" = 400 FT WORK COPY

SEE MAP 19 12 23 33

SEE MAP 19 12 23 30

P.O.D. LOCATED
FROM COMMON SECTION 22, 23, 26, 27

2690 FT SOUTH
480 FT EAST

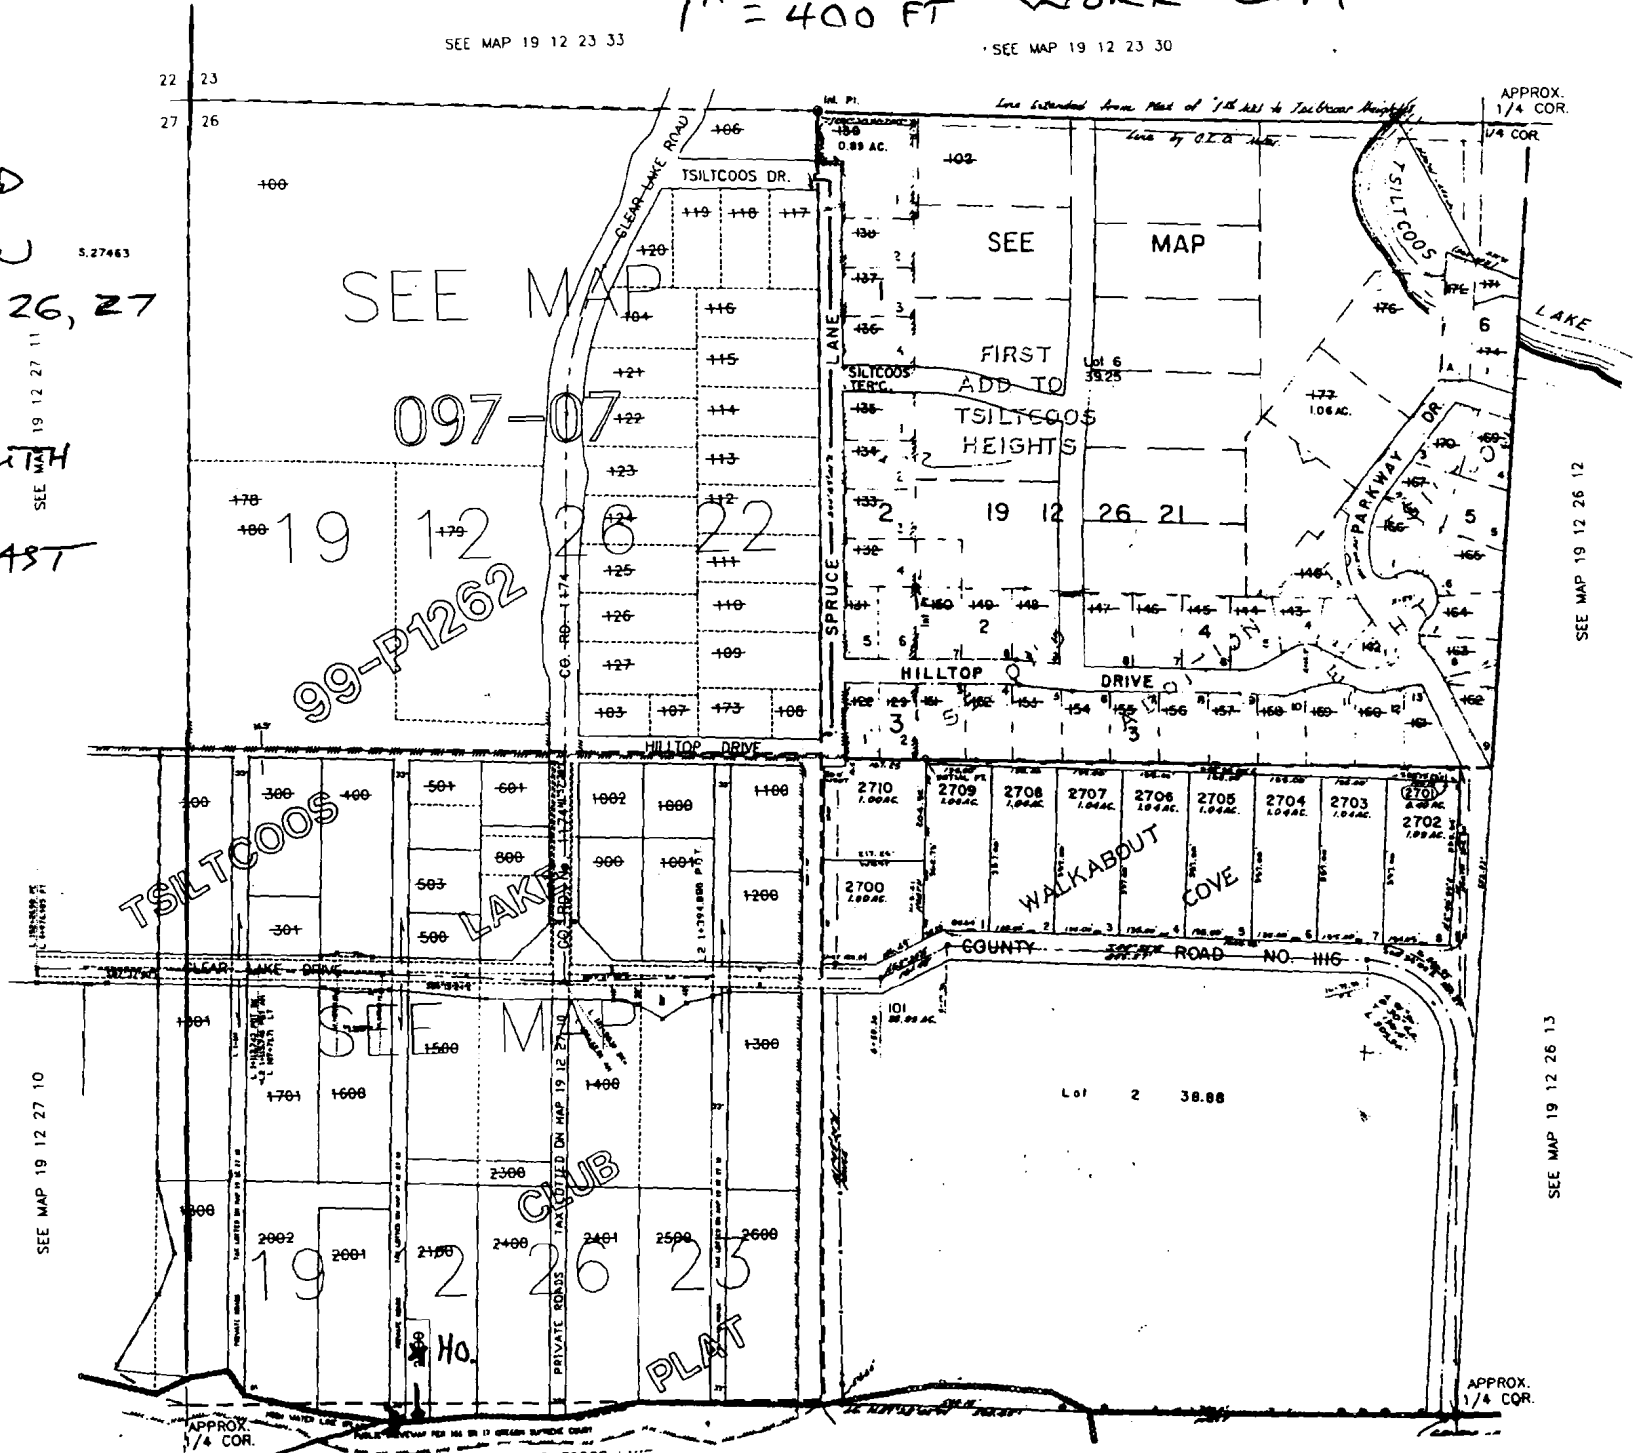

WATER RESOURCES DEPT
SALEM OREGON

NOV 24 2003

RECEIVED

SEE MAP 19 12 27 10

SEE MAP 19 12 26 13

SEE MAP 19 12 26 12

APPROX. 1/4 COR.

APPROX. 1/4 COR.