


SW 1/4 SECTION 24 T.19S. R.12W. W.M.
 LANE COUNTY
 Scale: 1" = 500'

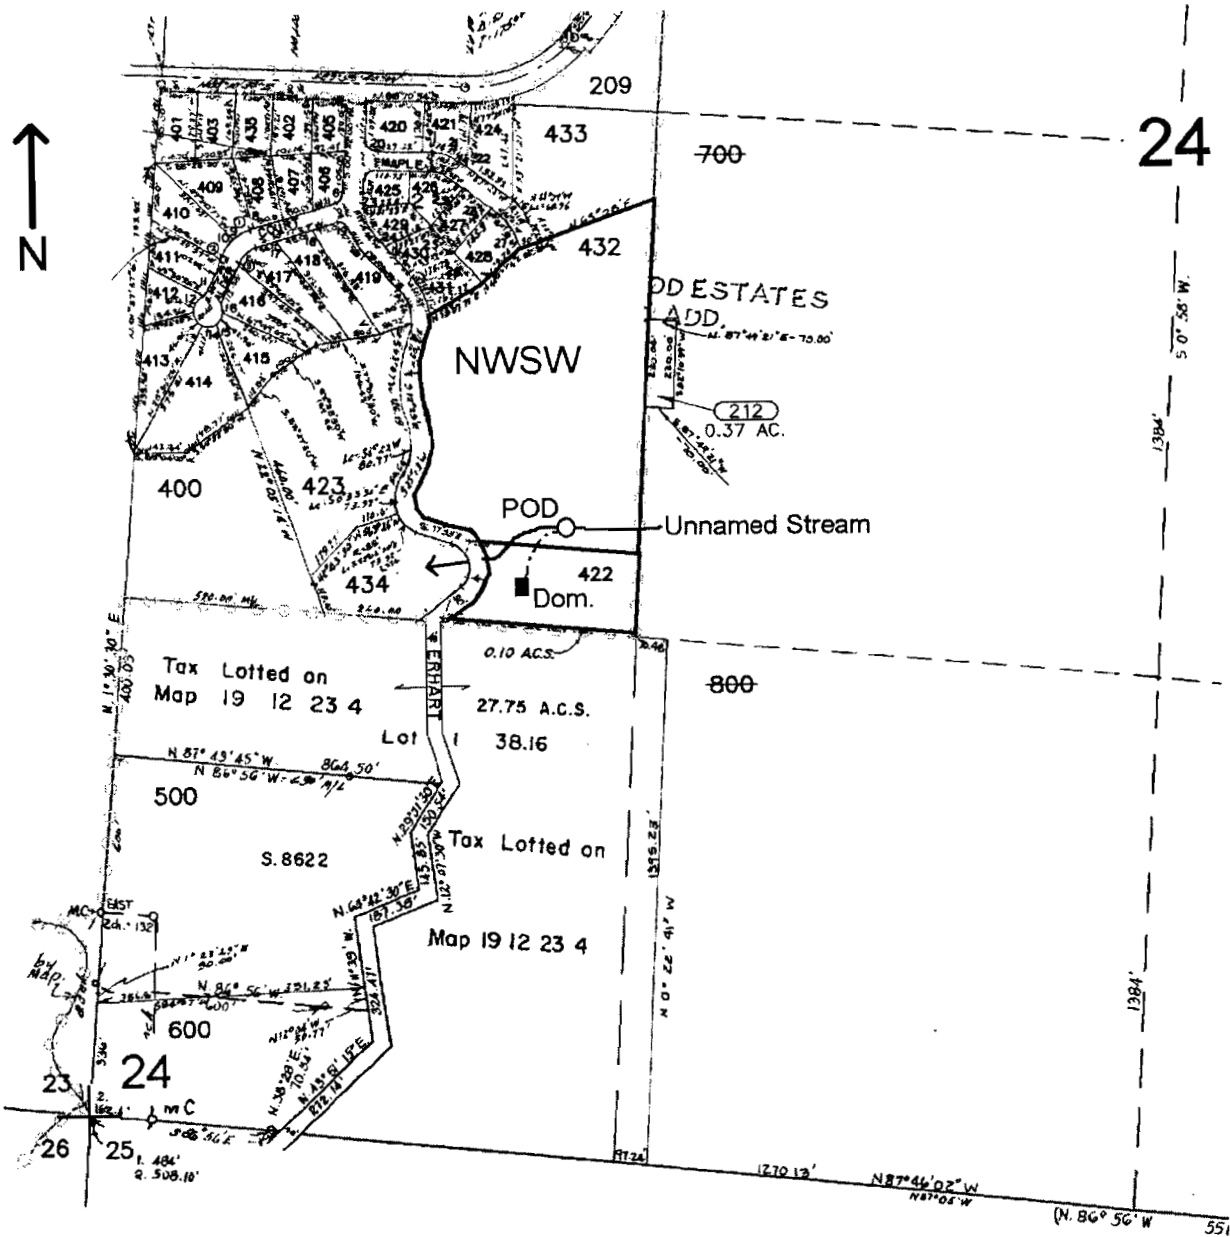

POD is located 1150 ft. S. and 1030 ft. E. from the W1/4 corner of Sec. 24

app no s-86354

RECEIVED
 JUN 29 2005
 WATER RESOURCES DEPT
 SALEM, OREGON