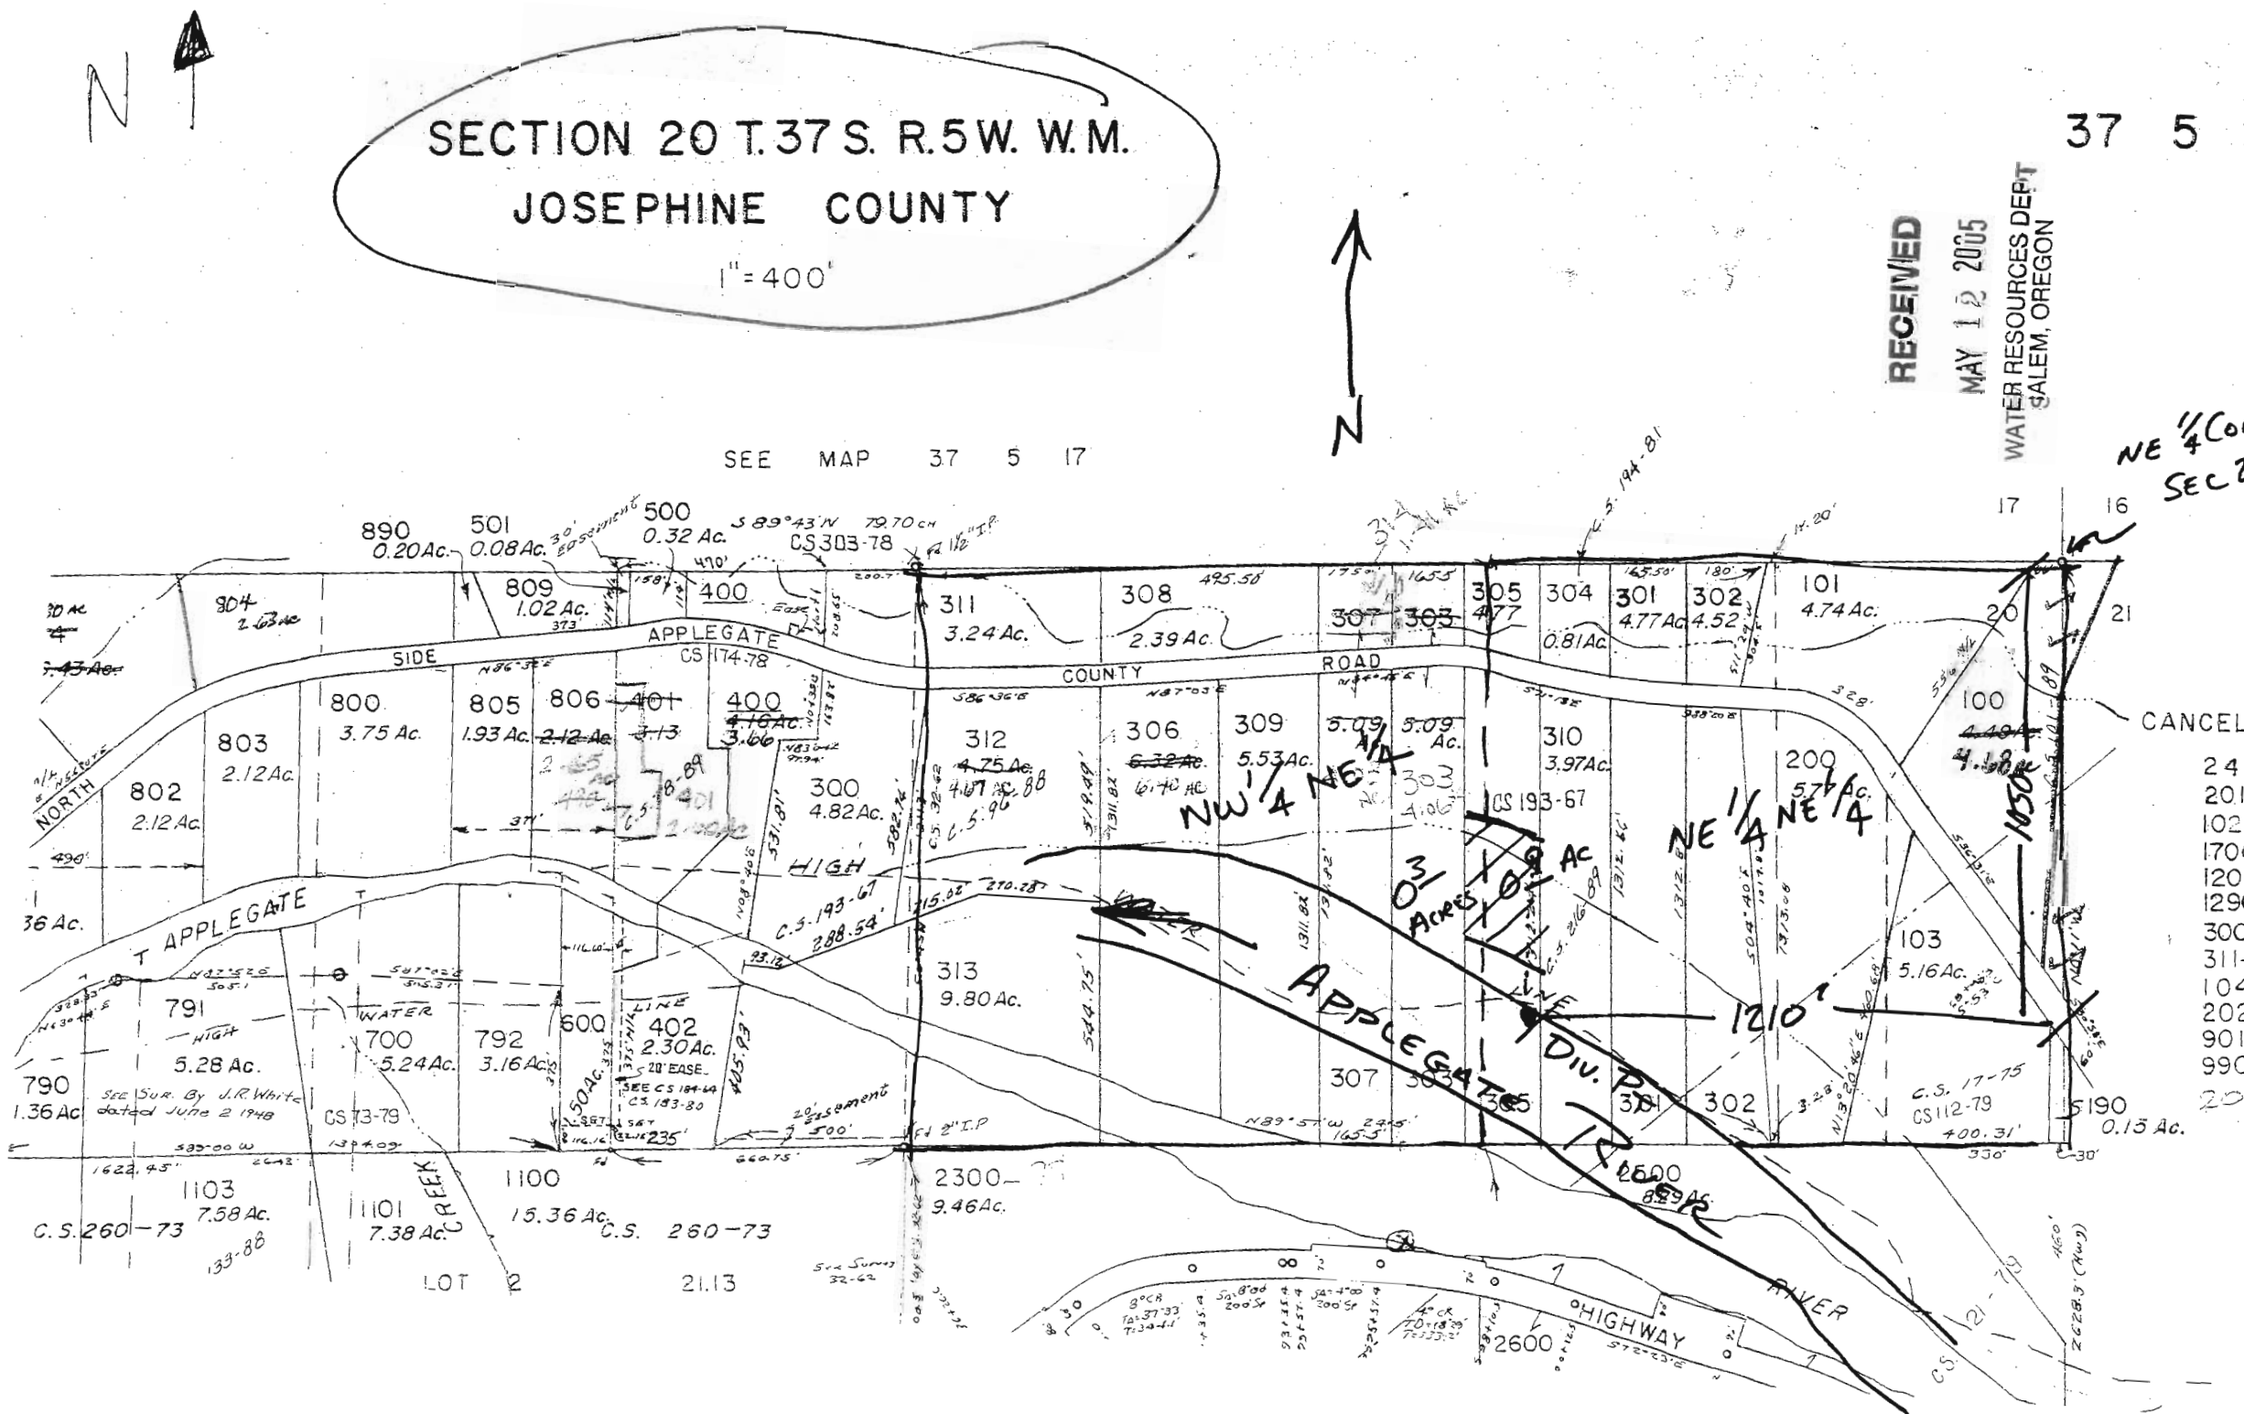

RECEIVED
MAY 12 2005
WATER RESOURCES DEPT
SALEM, OREGON