


T36 S R3 W W.M.

MAP TO ACCOMPANY APPLICATION
FOR DENNIS M. FARMER
SOURCE - LOST CREEK LAKE

0-4

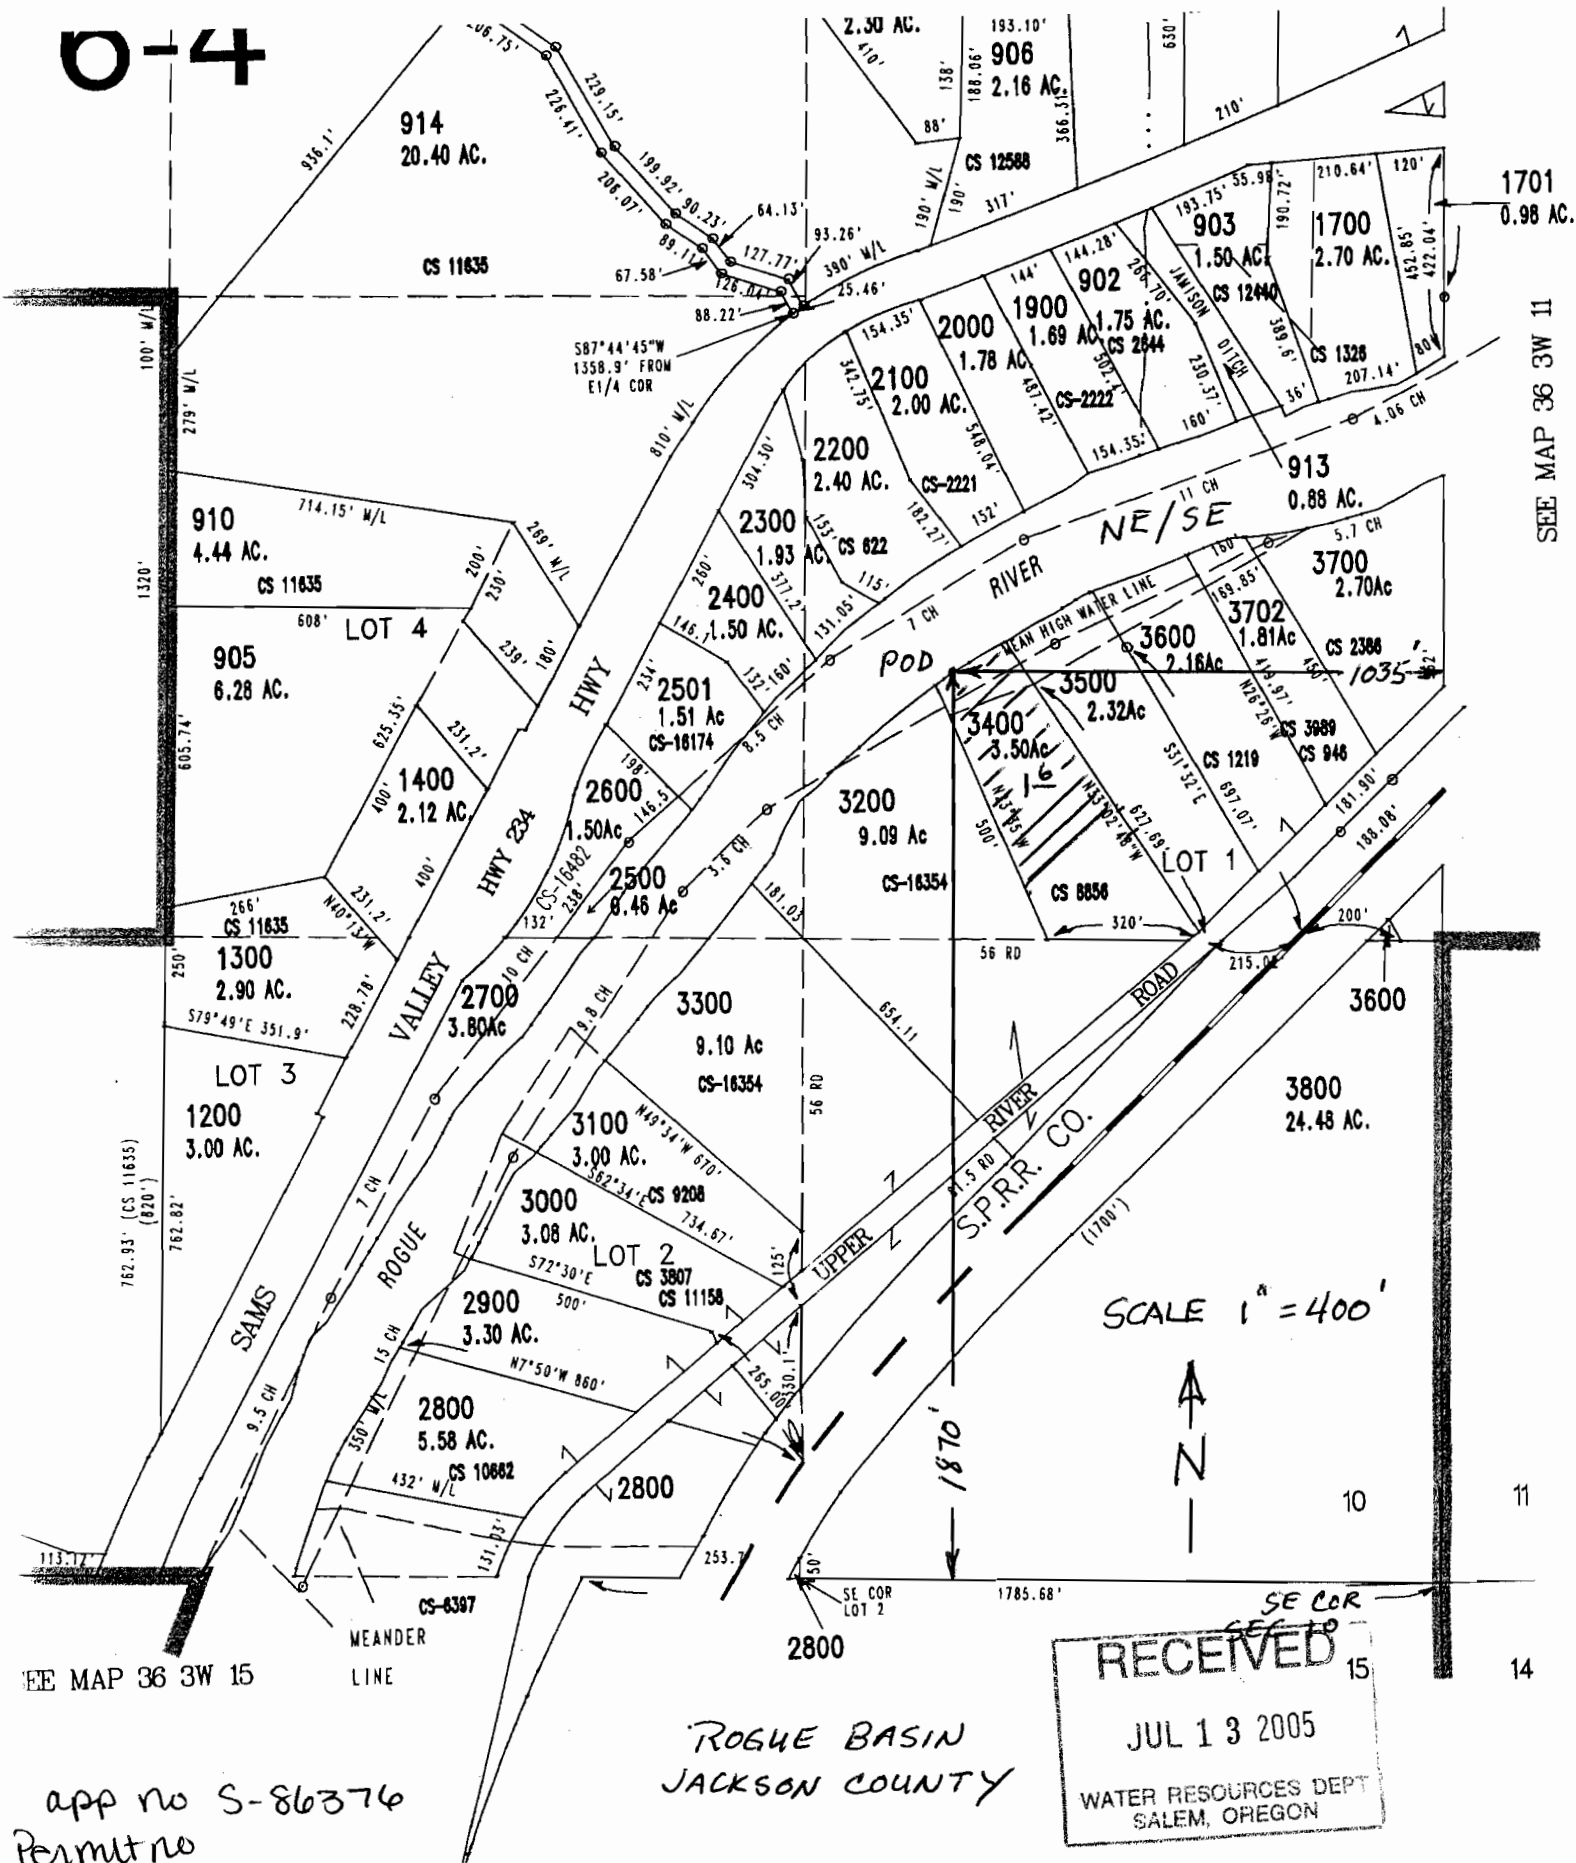

SEE MAP 36 3W 11

SEE MAP 36 3W 15

app no S-86376
Permit no

ROGUE BASIN
JACKSON COUNTY

RECEIVED
JUL 13 2005
WATER RESOURCES DEPT
SALEM, OREGON