WATER RIGHT APPLICATION MAP

FOR

JACKUSON CREEK PROPERTIES, LLC
33499 KAMMEYER ROAD
SCAPPOOSE, OREGON 97056

RECEIVED
MAY 09 2005
WATER RESOURCES DEPT
SALEM, OREGON

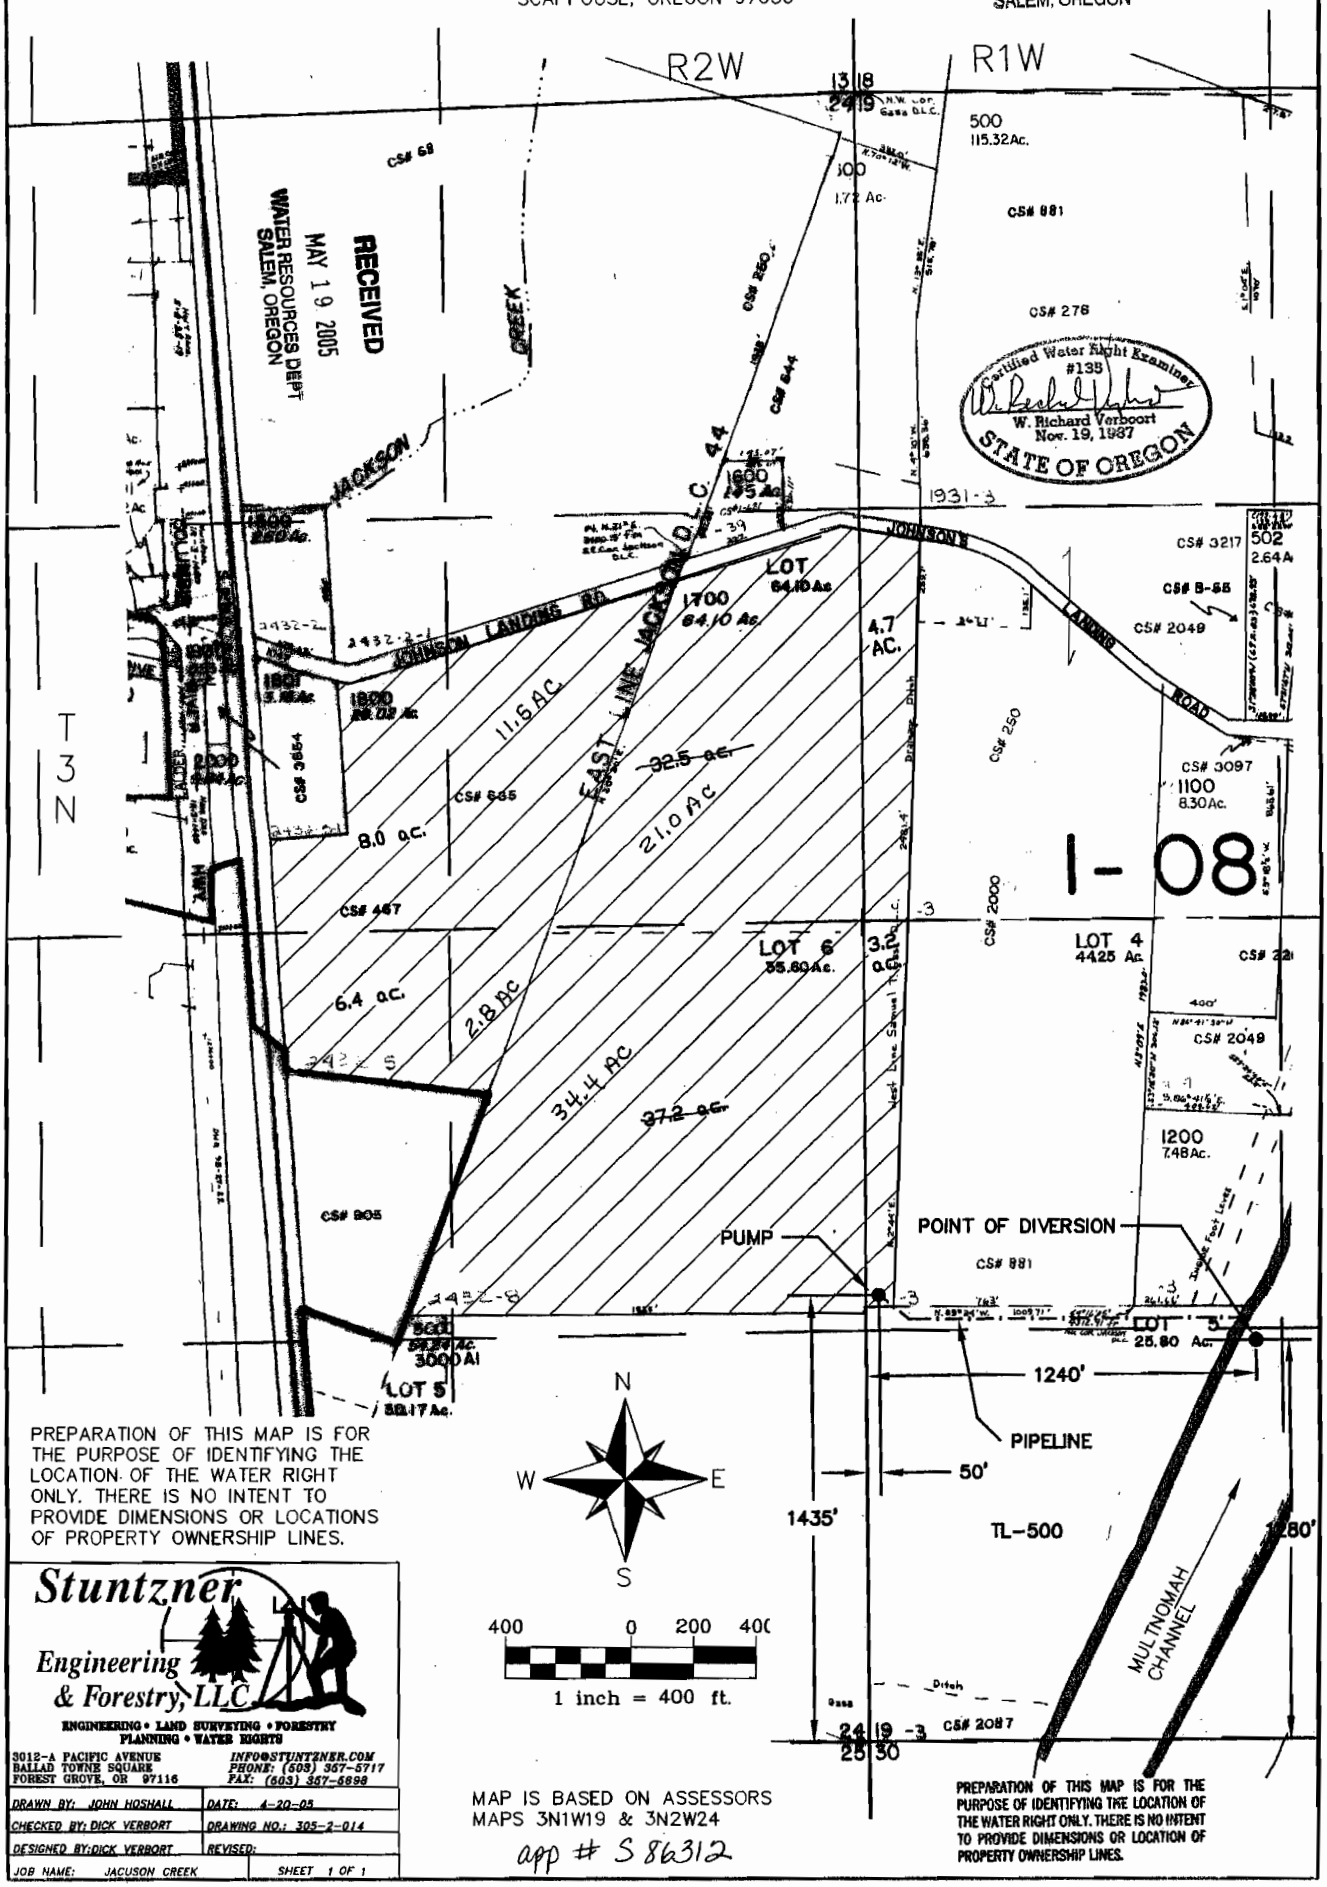

PREPARATION OF THIS MAP IS FOR THE PURPOSE OF IDENTIFYING THE LOCATION OF THE WATER RIGHT ONLY. THERE IS NO INTENT TO PROVIDE DIMENSIONS OR LOCATIONS OF PROPERTY OWNERSHIP LINES.

Stuntzner Engineering & Forestry, LLC
ENGINEERING • LAND SURVEYING • FORESTRY
PLANNING • WATER RIGHTS
3012-A PACIFIC AVENUE
BALLAD TOWNE SQUARE
FOREST GROVE, OR 97116
INFO@STUNTZNER.COM
PHONE: (503) 357-5717
FAX: (503) 357-6898

DRAWN BY: JOHN HOSHALL	DATE: 4-20-05
CHECKED BY: DICK VERBORT	DRAWING NO.: 305-2-014
DESIGNED BY: DICK VERBORT	REVISED:
JOB NAME: JACUSON CREEK	SHEET 1 OF 1

MAP IS BASED ON ASSESSORS MAPS 3N1W19 & 3N2W24

app # S 86312

PREPARATION OF THIS MAP IS FOR THE PURPOSE OF IDENTIFYING THE LOCATION OF THE WATER RIGHT ONLY. THERE IS NO INTENT TO PROVIDE DIMENSIONS OR LOCATION OF PROPERTY OWNERSHIP LINES.