


# Application to Appropriate Water Right


**Wild River, Inc.**  
**T 36 S, R 2 W, Section 11 & 14 W.M.**

**RECEIVED**  
 MAR 23 2005  
 WATER RESOURCES DEPT  
 SALEM, OREGON

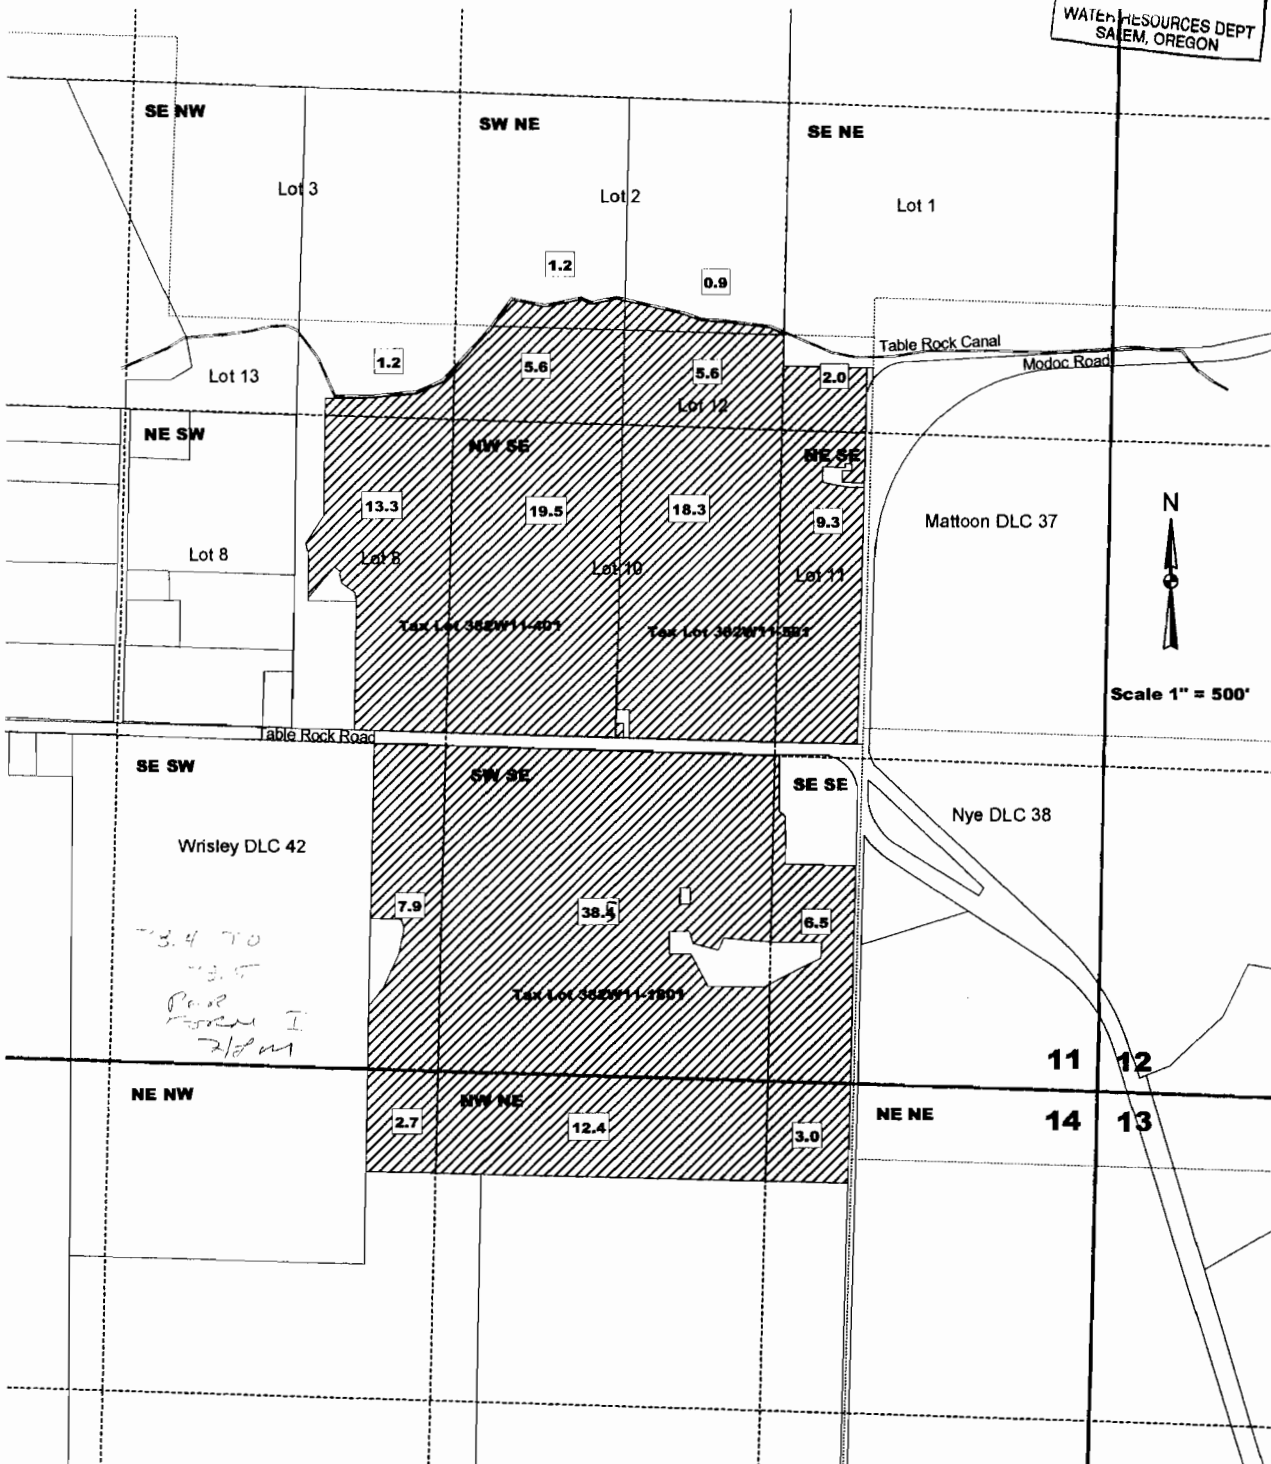

*3.4 to  
 3.5  
 Part  
 from I  
 2/8/05*

*app # 586215*

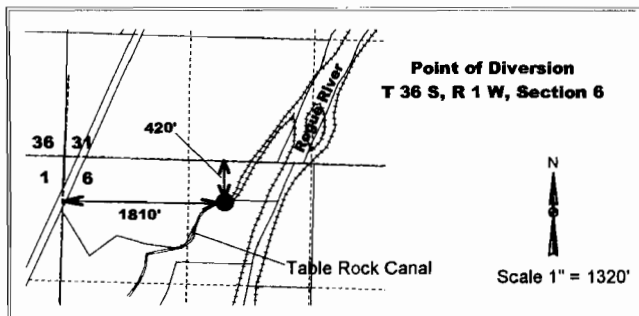

**FARBER**  
**SURVEYING**  
 PO Box 5286  
 Central Point, Oregon 97502  
 Phone 541-664-5599  
 Fax 541-664-5603  
 Email [hfarber@charter.net](mailto:hfarber@charter.net)  
 Farber & Sons, Inc.  
 431 Oak Street  
 Central Point, Oregon  
 Tax ID: 93-1057173