NW1/4 SEC. 19 T.26S. R.4 W W.M.
DOUGLAS COUNTY
Scale: 1" = 500'

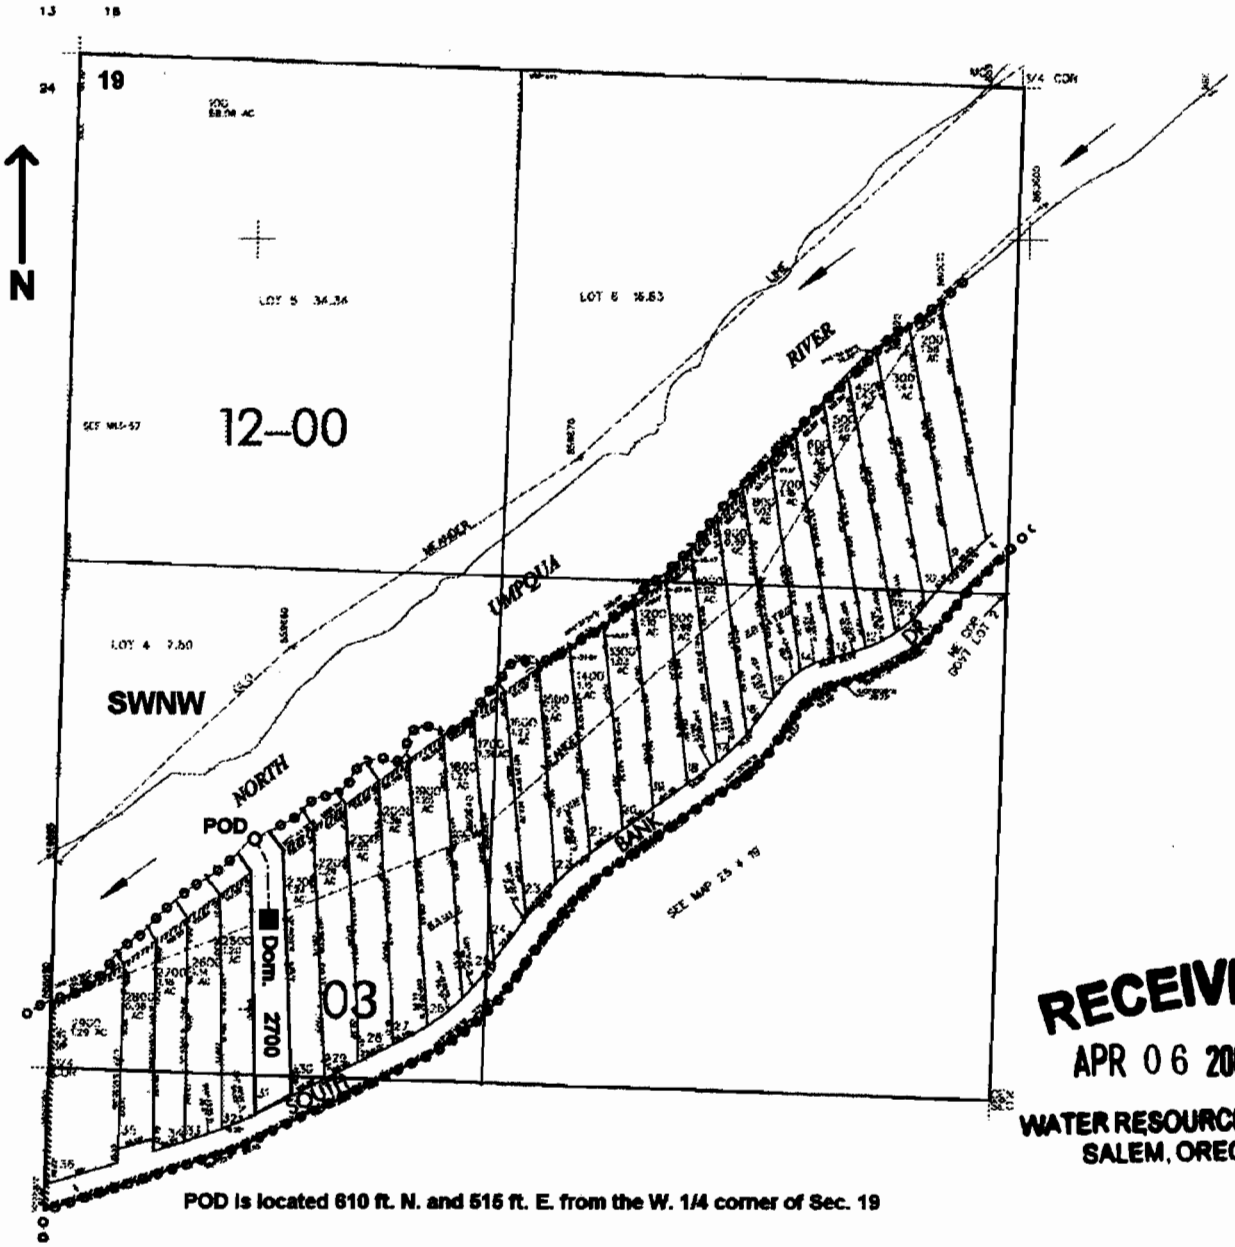

POD is located 610 ft. N. and 515 ft. E. from the W. 1/4 corner of Sec. 19

RECEIVED
APR 06 2005
WATER RESOURCES DEPT
SALEM, OREGON

app # S 86237