


Tax lot 1200  
35 1W 5  
Jackson County, Ore

1 inch = 400 ft.

APP Point  
should be  
1250' E


App. Point  
2000' N  
1250' S from  
South  $\frac{1}{4}$  Cor Section 5

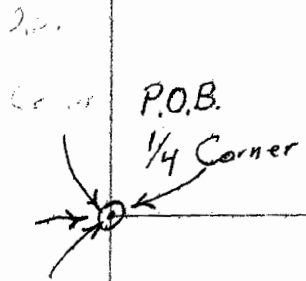


**RECEIVED**  
JUN 27 2005  
WATER RESOURCES DEPT  
SALEM, OREGON

NE  $\frac{1}{4}$  SW  $\frac{1}{4}$

NW  $\frac{1}{4}$   
SE  $\frac{1}{4}$

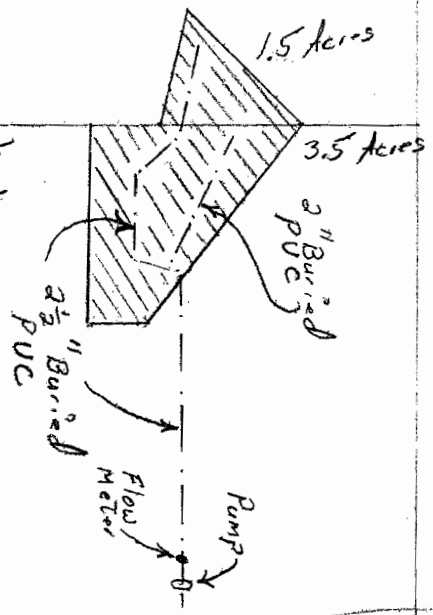

Regue River

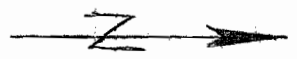

S-86352