

MAP WAS PREPARED FOR
ASSESSMENT PURPOSE ONLY.



app # 586307

NW1/4 NW1/4 SEC.30 T.26S. R.5W.

SEE MAP 26 5 19CC

DOUGLAS COUNTY

1" = 100'

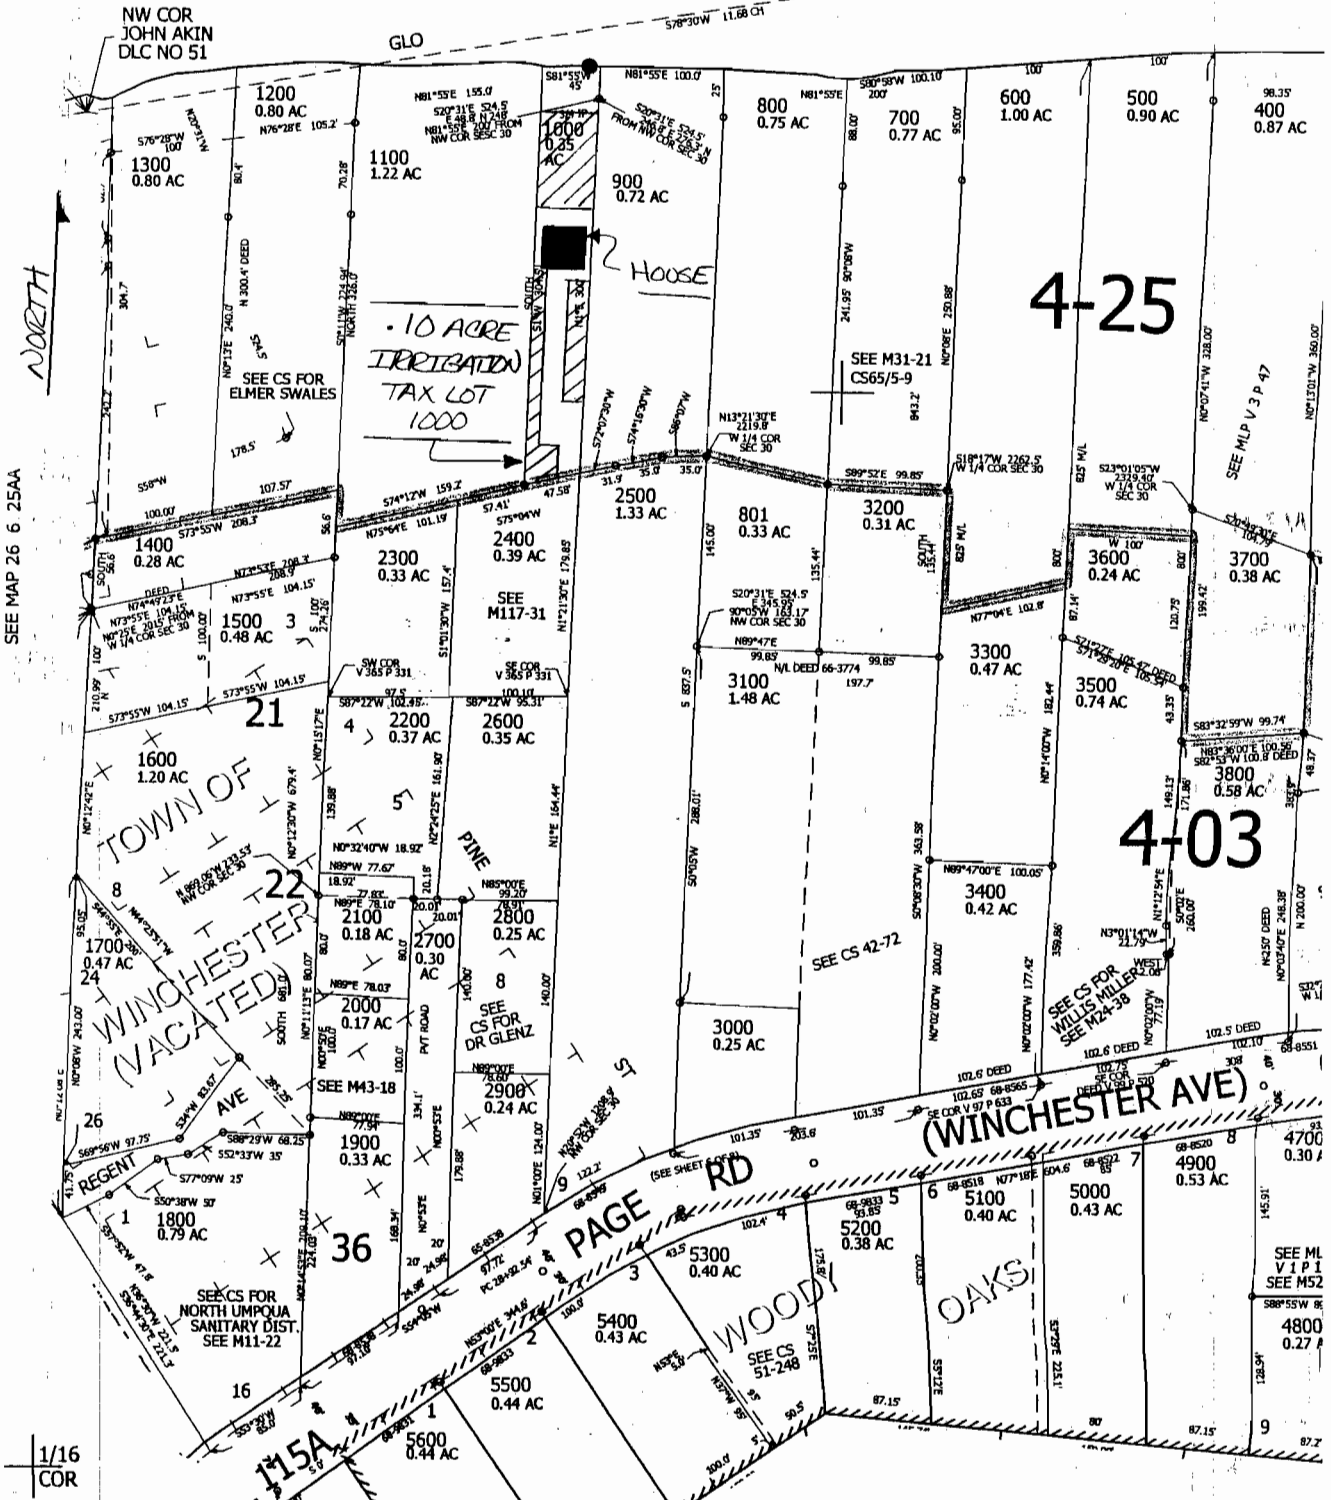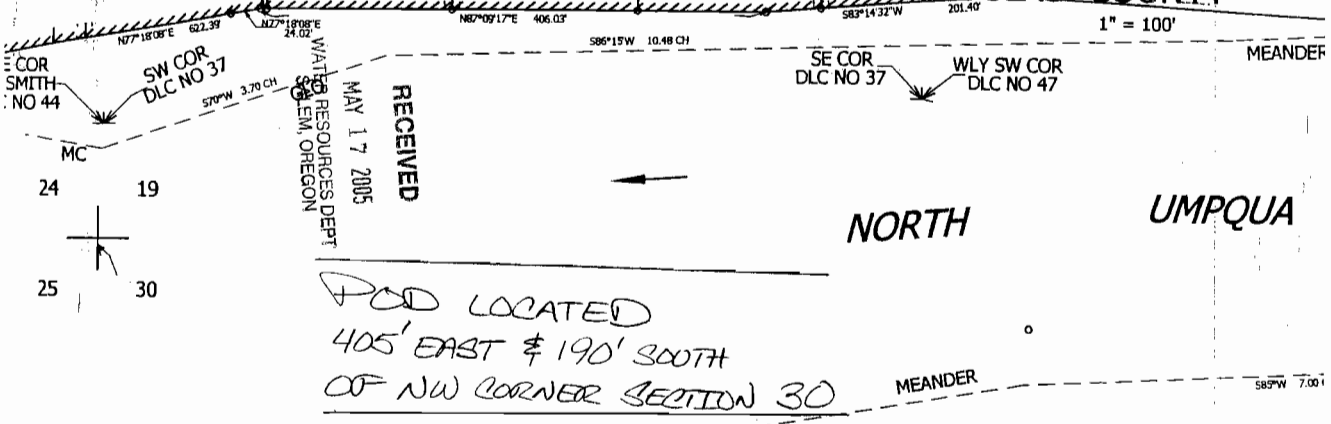

SEE MAP 26 6 25AA

NORTH

NORTH

UMPQUA

4-25

4-03

1/16
COR